

Rochester Half Marathon

Frontier Field, Rochester, New York


Measured on: August 23, 2015

By: Kevin P. Lucas - 585-421-9626







NY15133KL

Effective
08/27/2015 to
12/31/2025

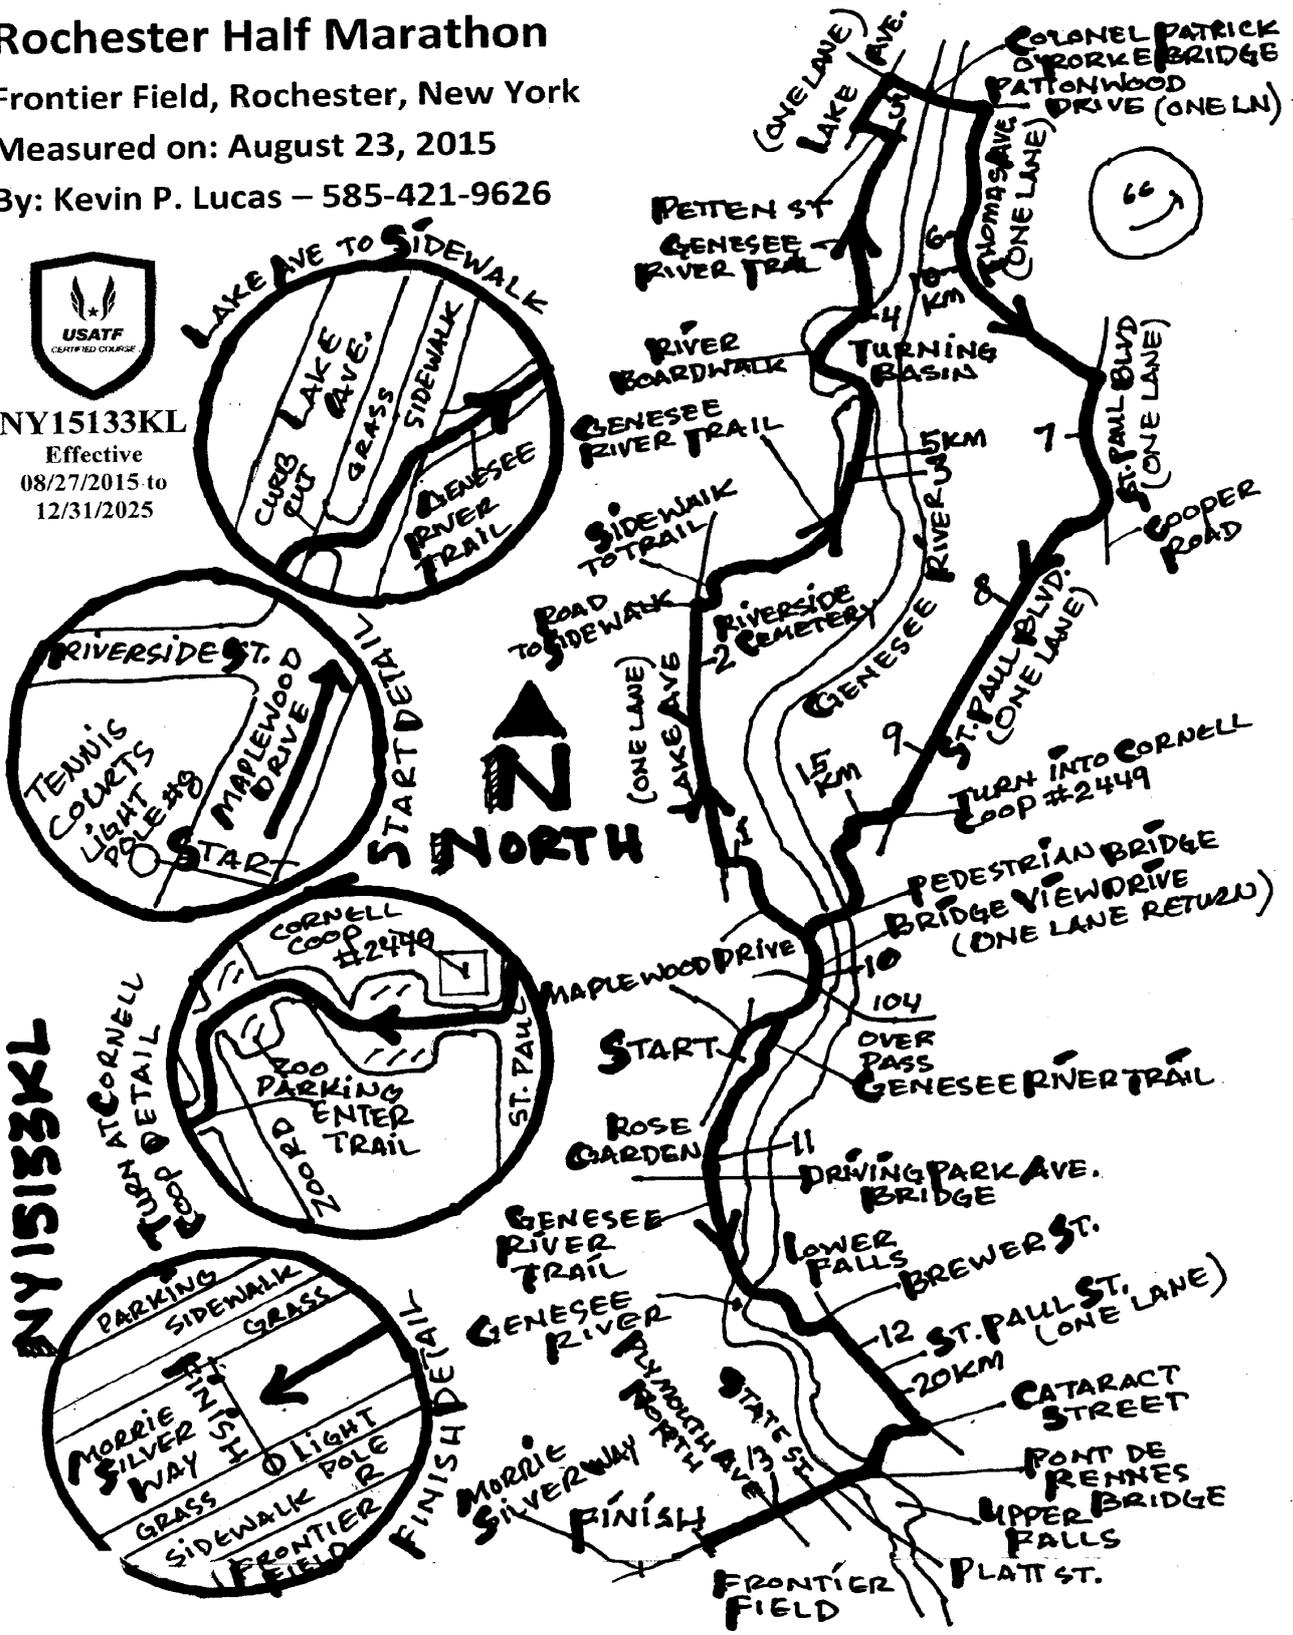

NY15133KL

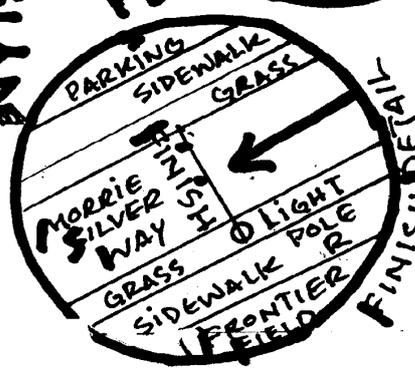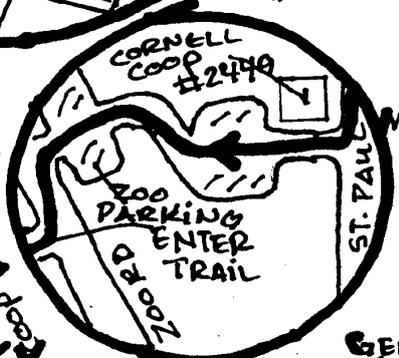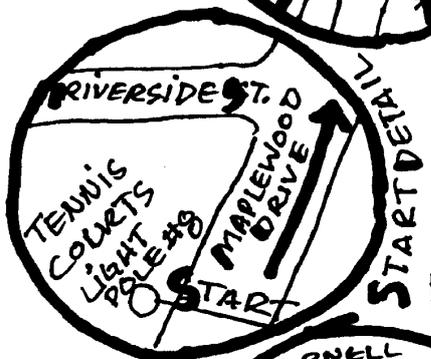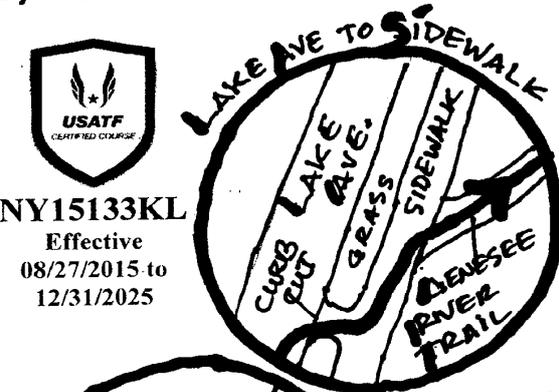



**Road Running Technical Council
USA Track & Field
Measurement Certificate**



Name of the course Rochester Half Marathon Distance 21.0975 km
 Location (state) New York (city) Rochester
 Type of course: road race calibration track Configuration: loop
 Type of surface: paved 99 % dirt % gravel 1 % grass % track %
 Elevation (meters above sea level) Start 134 Finish 153 Highest 154 Lowest 76
 Straight line distance between start & finish 3.5 km Drop -0.9 m/km Separation 16.6 %
 Measured by (name, address, phone & e-mail) Kevin P. Lucas, 94 South Ridge Trail, Fairport, NY
14450-3843, 585-421-9626, & k_p_lucas@frontiernet.net
 Race contact (name, address, phone & e-mail) Boots, c/o YellowJacket Racing, 155 Culver Road, Suite 110
Rochester, NY 14620-1678, 585-732-1090
 Measuring Methods: bicycle steel tape electronic distance meter
 Number of measurements of entire course: 2 Date(s) when course measured: August 23, 2015
 Race date: September 20, 2015 Course certification effective date: August 27, 2015
 Certification code: NY15133KL

Notice to Race Director: Use this Certification Code in *all* public announcements relating to your race.


Be It Officially Noted That

Based on examination of data provided by the above named measurer, the course described above and in the map attached is hereby certified as reasonably accurate in measurement according to the standards adopted by the Road Running Technical Council. If *any* changes are made to the course, this certification becomes void, and the course must then be recertified.

Verification of Course — In the event a National Open Record is set on this course, or at the discretion of USA Track & Field, a verification remeasurement may be required to be performed by a member of the Road Running Technical Council. If such a remeasurement shows the course to be short, then all pending records will be rejected and the course certification will be cancelled.

This certification expires on December 31 in the year **2025**

AS NATIONALLY CERTIFIED BY:

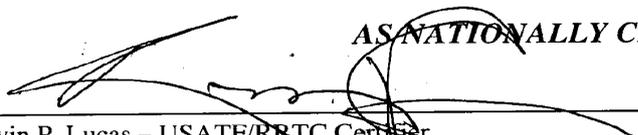

Date: August 27, 2015

Kevin P. Lucas – USATF/RRTC Certifier
 94 South Ridge Trail, Fairport, NY 14450-3843, 585-421-9626, & k_p_lucas@frontiernet.net



NY15133KL
Effective
08/27/2015 to
12/31/2025

Rochester Half Marathon

Frontier Field, Rochester, New York

Measured on: August 23, 2015

By: Kevin P. Lucas – 585-421-9626

Measured Marks:

- Start @ 440 feet elevation: on Maplewood Drive at Maplewood Park Tennis Courts, light pole #8 on West side of road
- 1 Mile @407 feet elevation: on Maplewood Drive at Lake Avenue, 62 feet 7" East of storm drain at corner on North side of road
- 2 Mile: on Lake Avenue at Riverside Cemetery Chapel of Peace (light pole #266), 12 feet South of storm drain East side of road
- 3 Mile @ 315 feet elevation: on Genesee River Trail North of trail split, 70 meters North of TP #140 sign on West side of trail
- 5 km @ 288 feet elevation: on Genesee River Trail, 86 feet 7" South of pipping grate that crosses trail
- 4 Mile @ 245 feet elevation: on Genesee River Trail (Turning Basin Boardwalk North end 181 meters North of TP #210), 7 feet 4" North of concrete pier for trail/boardwalk
- 5 Mile @ 289 feet elevation: at Building #4292 Lake Avenue, 10 feet 2" South of center of exit driveway on East side of road
- 6 Mile @ 357 feet elevation: at House #570 Thomas Avenue, 26 feet 5" North of power pole RGE #35 on West side of road
- 10 km @ 362 feet elevation: at House #431 Thomas Avenue, 44 feet North of power pole RGE #24 on West side of road
- 7 Mile @ 372 feet elevation: at House #3975 St. Paul Blvd, 31 feet 7" South of center of driveway on West side of road
- 8 Mile @ 398 feet elevation: at House #3277 St. Paul Blvd, 17 feet 7" South of storm drain on West side of road
- 9 Mile @ 410 feet elevation: at House #2573 St. Paul Blvd, 33 feet 10" South of power pole RGE #1A on West side of road
- 15 km: on pass thru drive East side of gate for Zoo Parking Lot, 15 feet 7" East of Gate towards Cornell Coop
- 10 Mile: on Maplewood Drive at trail/road dividing wall North of 104 Overpass, 8 feet South of North end on East side of road
- 11 Mile @ 450 feet elevation: on Genesee River Trail at Maplewood Rose Garden, 46 meters South of old stone concession building on West side of trail
- 12 Mile @ 491 feet elevation: on St. Paul Street at Hart Street, 34 feet 6" North of RTS Bus Stop #3686 on West side of road
- 20 km: on St. Paul Street at Gorham Street (Genesee Brewery parking lot with beer can storage tanks), 22 feet 8" North of light pole #43 on West side of road
- 13 Mile @ 499 feet elevation: on Platt Street at Plymouth Avenue N, at Pedestrian Xing sign on North side of road
- Finish @ 502 feet elevation: on Morrie Silver Way, at light pole #R with Pedestrian Xing sign on South side of road