

Alternate Shoreline Half Marathon

Hamlin Beach State Park, Hamlin, New York


Measured on: July 8, 2017 (11 mile to Finish) & July 10, 2015 (NY15127KL)

By: Kevin P. Lucas – lucasmeasurement@gmail.com



NY15142KL

Effective
07/11/2017 to
12/31/2025

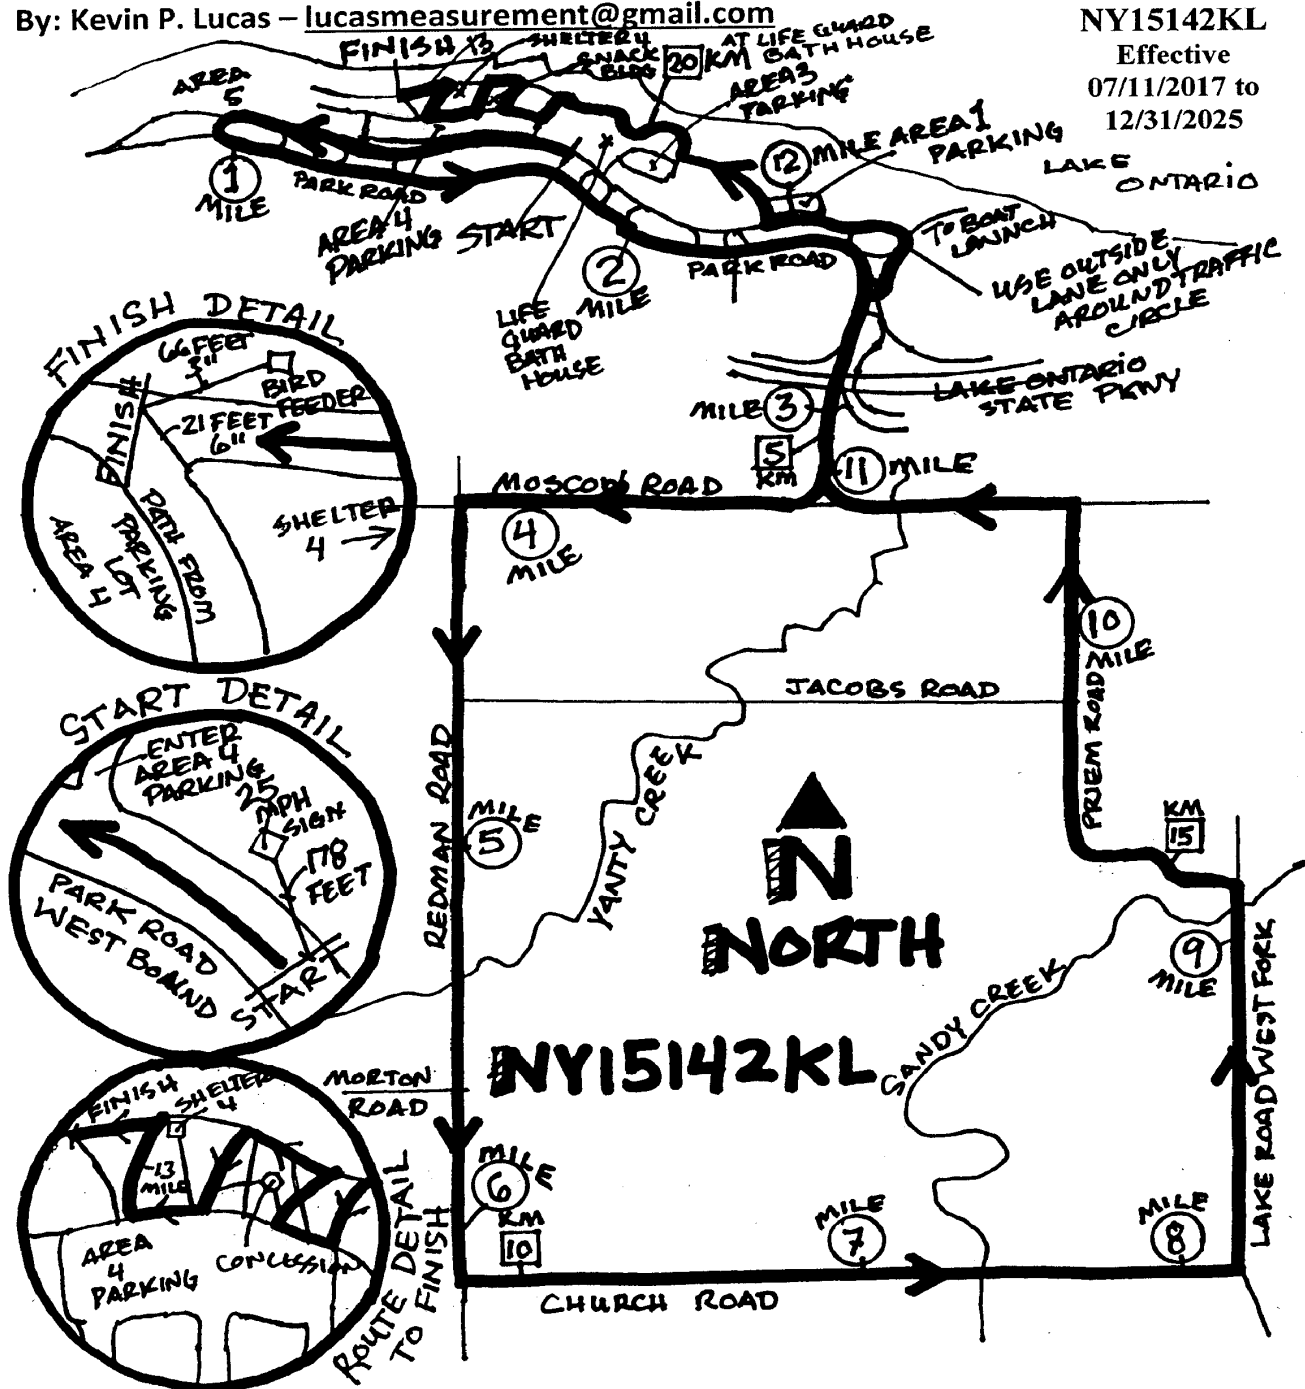



Road Running Technical Council
USA Track & Field

Measurement Certificate

recognized by



Name of the course Alternate Shoreline Half Marathon Distance 21.0975 km
Location (state) New York (city) Hamlin
Type of course: road race ☒ calibration course ☐
Measuring method: bicycle ☒ steel tape ☐ electronic distance meter ☐
Measured by (name, address, phone & e-mail) Kevin P. Lucas, 94 South Ridge Trail, Fairport, NY
14450-3843, 585-421-9626 & lucasmeasurement@gmail.com
Race contact (name, address, phone & e-mail) Boots, YellowJacket Racing,
155 Culver Road, Suite 110, Rochester, NY 14620-1678, 585-732-1090
Date(s) when course measured: July 8, 2017 (11 mile to Finish) & July 10, 2015 (NY15127KL)
Number of measurements of entire course: 2 Course Configuration: figure-8
Elevation (meters above sea level) Start 79.3 Finish 82.9 Highest 101.8 Lowest 77.2
Straight line distance between start & finish 616 meters Drop -0.17 m/km Separation 2.92 %
Type of surface: paved 100 % dirt % gravel % grass % track %
Effective date of certification: July 11, 2017 Certification code: NY15142KL

Notice to Race Director: Use this Certification Code
in *all* public announcements relating to your race.

Be It Officially Noted That

Based on examination of data provided by the above named measurer, the course described above and in the map attached is hereby certified as reasonably accurate in measurement according to the standards adopted by the Road Running Technical Council. If *any* changes are made to the course, this certification becomes void, and the course must then be recertified.

Verification of Course — In the event a National Open Record is set on this course, or at the discretion of USA Track & Field, a verification remeasurement may be required to be performed by a member of the Road Running Technical Council. If such a remeasurement shows the course to be short, then all pending records will be rejected and the course certification will be cancelled.

This certification expires on December 31 in the year

2025

AS NATIONALLY CERTIFIED BY:

Date: July 11, 2017

Kevin P. Lucas - USATF/RRTC Certifier

94 South Ridge Trail, Fairport, NY 14450-3843, 585-421-9626 & lucasmeasurement@gmail.com

Alternate Shoreline Half Marathon

Hamlin Beach State Park, Hamlin, New York

Measured on: July 8, 2017 (11 mile to Finish) & July 10, 2015 (NY15127KL)

By: Kevin P. Lucas – lucasmeasurement@gmail.com



NY15142KL

Effective
07/11/2017 to
12/31/2025

2015 Measured Marks & Elevations:

Start @ 260 feet elevation: on Park Rd (East Bound) East of Area 4 Parking Lot,
178 feet East of 25 MPH sign on North side of road
1 Mile @ 272 feet elevation: on Park Rd (West Bound) at Dead End Area 5,
227 feet East of One Way sign on South side of road
2 Mile @ 269 feet elevation: on Park Rd (West Bound) East of Area 3 Parking,
136 feet East of 25 MPH sign on South side of road
3 Mile @ 263 feet elevation: on Park Exit Rd (South Bound) South of PKWY,
26 feet North of Rochester Moscow Rd sign on West side of road
5 km @ 267 feet elevation: on Park Exit Rd (to Moscow Rd) South of Park Maintenance Rd,
41 feet 3" North of culvert posts on East side of road
4 Mile @ 289 feet elevation: at #1291 Moscow Rd, 19 feet West of power pole #1288 on South side of road
5 Mile @ 306 feet elevation: at #856 Redman Rd, at post at North edge of driveway on East side of road
6 Mile @ 330 feet elevation: at #1296 Redman Rd, 81 feet 8" South of 45 MPH sign on East side of road
10 km @ 326 feet elevation: at #3100 Church Rd, 38 feet East of mailbox #3100 on North side of road
7 Mile @ 319 feet elevation: at #2770 Church Rd, 20 feet 7" West of yellow fire hydrant on North side of road
8 Mile @ 318 feet elevation: at #2346 Church Rd, 30 feet 6" West of yellow fire hydrant on North side of road
9 Mile @ 278 feet elevation: on Lake Road West Fork at South side of Sandy Creek Bridge,
8 feet 6" South of No Parking sign on West side of road
15 km @ 288 feet elevation: West of #501 Priem Rd at curve,
162 feet East of 15 MPH & Curve Arrow signs on North side of road
10 Mile @ 279 feet elevation: West of #126 Priem Rd, 93 feet South of Power Pole #NW25 on East side of road

2017 Measured Marks & Elevations:

11 Mile @ 274 feet elevation: on Park Exit Rd North of Moscow Rd,
56 feet 9" South of stone entrance posts on East side of road
12 Mile @ 245 feet elevation: on Park Rd (West Bound) at Area 1 Parking Lot,
9 feet 8" East of 25 MPH sign on North side of road
20 km @ 261 feet elevation: on Park Bike Path East of Life Guard/Bath Bldg. at Area 3,
41 feet 7" North of fence posts on South side of path
13 Mile @ 270 feet elevation: on Park Bike Path from Area 4 Parking Lot to Shelter 4,
at High Voltage Box on East side of path
Finish @ 272 feet elevation: on Park Bike Path 130 meters West of Shelter 4 at intersection of path from parking lot
& playground, 66 feet 3" West of bird feeder on North side of path & 21 feet 6" to corner where paths meet