

# Michelle's Memorial 5 km - Middleport, New York

Measured on: May 29, 2014 - By: Kevin P. Lucas - 585-421-9626

**Elevations:**

Start = 504 feet

Finish = 509 feet


Highest = 517 feet

Lowest = 474 feet



NY1414KL

Effective  
05/31/2014 to  
12/31/2024

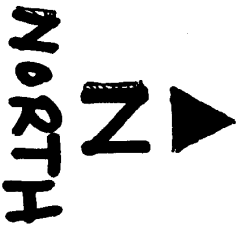

**Measured Marks:**

Start: on Mill Street at N. Hartland Street, at power pole #NM1 5 on South side of road.


1 Mile: 523 feet (160 meters) East of mailbox at #9488 Townline Road on South side of road.

2 Mile: East of Peet Street Bridge, 97 feet 4" East of #10 marker on South side of Canal path.

3 Mile: at #22 Mill Street, 32 feet 7" East of yellow fire hydrant on South side of road.

Finish: at #6 Mill Street, 35 feet 3" East of power pole #102 on South side of road.

NY1414KL

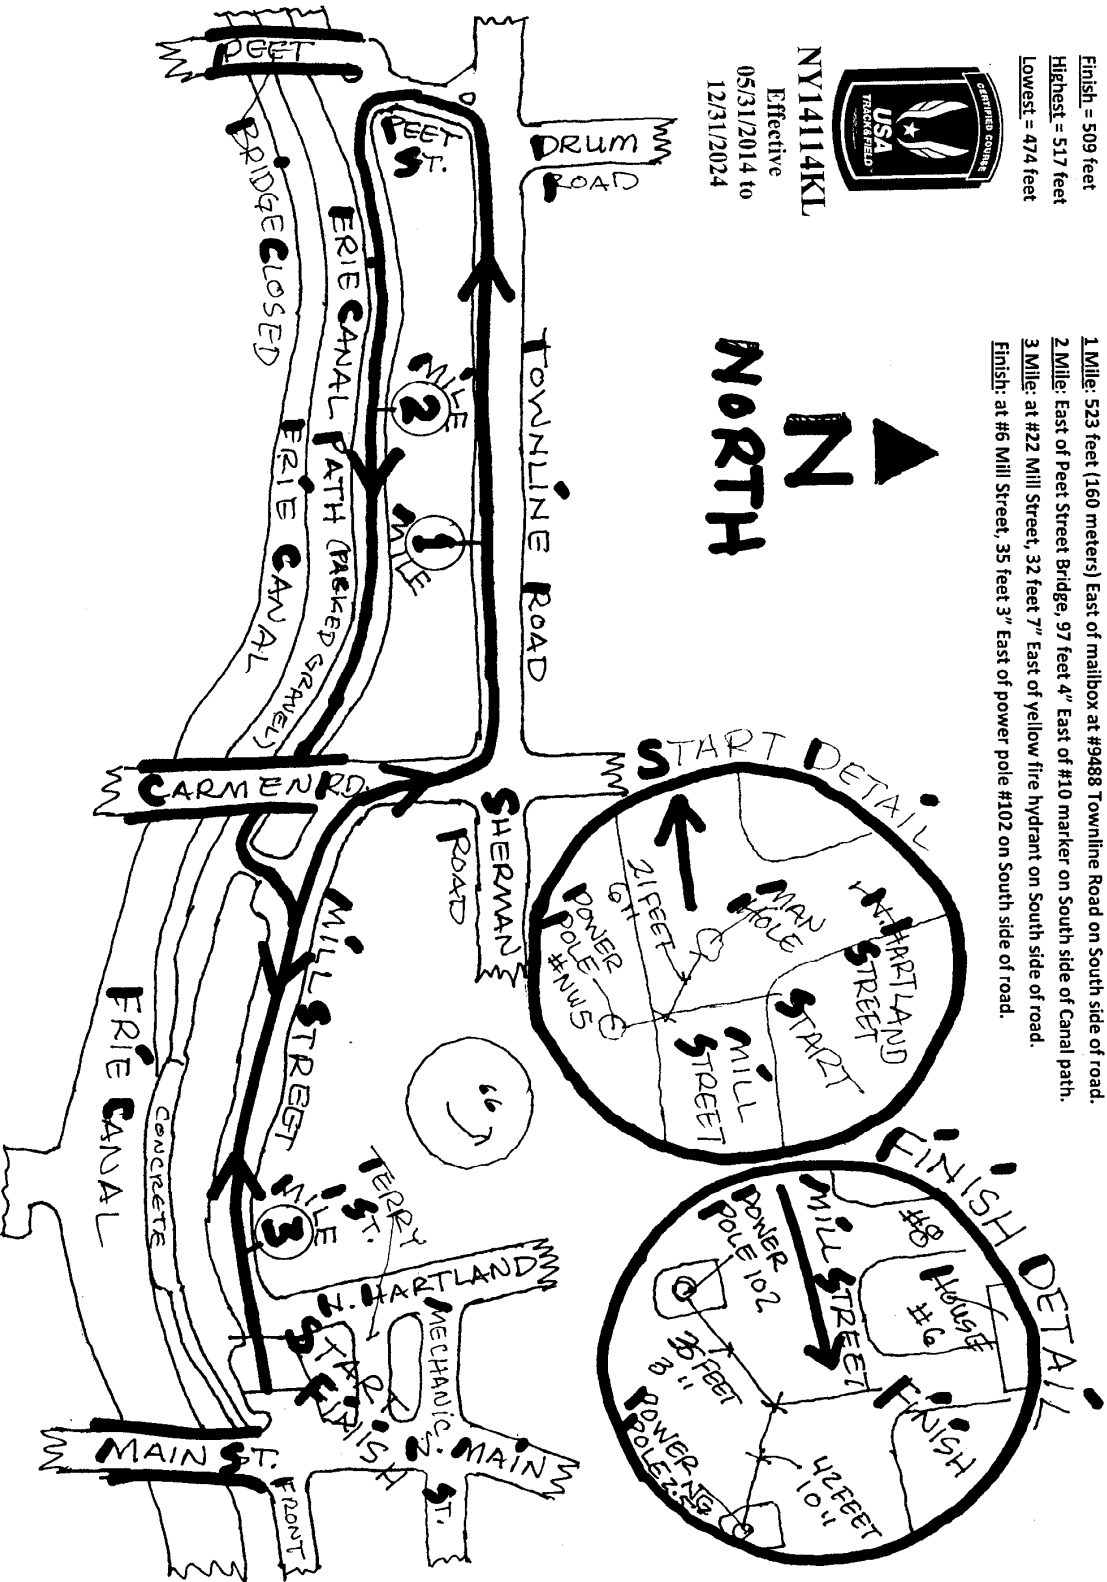



**Road Running Technical Council**  
**USA Track & Field**  
**Measurement Certificate**



Name of the course Michelle's Memorial 5 km Distance 5 km  
 Location (state) New York (city) Middleport  
 Type of course: road race  calibration  track  Configuration: keyhole  
 Type of surface: paved 65 % dirt      % gravel 35 % grass      % track      %  
 Elevation (meters above sea level) Start 154 Finish 155 Highest 158 Lowest 145  
 Straight line distance between start & finish 83 meters Drop -0.2 m/km Separation 1.67 %  
 Measured by (name, address, phone & e-mail) Kevin P. Lucas, 94 South Ridge Trail, Fairport, NY  
14450-3843, 585-421-9626, & k\_p\_lucas@frontiernet.net  
 Race contact (name, address, phone & e-mail) Brooke Yaiser, c/o Michelle A. Bewely Scholarship Fund,  
5432 Royalton Center Road, Middleport, NY 14105-9617, 716-783-2432  
 Measuring Methods: bicycle  steel tape  electronic distance meter   
 Number of measurements of entire course: 2 Date(s) when course measured: May 29, 2014  
 Race date: November 15, 2014 Course certification effective date: May 31, 2014  
 Certification code: NY14114KL

Notice to Race Director: Use this Certification Code in *all* public announcements relating to your race.

***Be It Officially Noted That***

Based on examination of data provided by the above named measurer, the course described above and in the map attached is hereby certified as reasonably accurate in measurement according to the standards adopted by the Road Running Technical Council. If *any* changes are made to the course, this certification becomes void, and the course must then be recertified.

**Verification of Course** — In the event a National Open Record is set on this course, or at the discretion of USA Track & Field, a verification remeasurement may be required to be performed by a member of the Road Running Technical Council. If such a remeasurement shows the course to be short, then all pending records will be rejected and the course certification will be cancelled.

***This certification expires on December 31 in the year*** **2024**

**AS NATIONALLY CERTIFIED BY:**

Date: May 31, 2014

Kevin P. Lucas – USATF/RRTC National Certifier  
 94 South Ridge Trail, Fairport, NY 14450-3843, 585-421-9626, & k\_p\_lucas@frontiernet.net