

# Yellowjacket Racing Course 704 - Perinton Park, Fairport, New York

Measured on: June 22, 2014 - By: Kevin P. Lucas - 585-421-9626

Measured Marks: Start: at #617 Whitney Road W., at Rene's Café sign and 28 feet 4" East of storm drain.

1 Mile: at #1043 Whitney Road E., 22 feet East of telephone pole at West side of driveway.

2 Mile: on Turk Hill Road South of RR overpass, 58 feet 7" South of concrete bridge overpass.

3 Mile: at #106 W. Church Street, 12 feet 11" West of light pole at West side of driveway.


5 km: at #130 W. Church Street, 24 feet 3" East of light pole at Nelson Street.

Finish: on O'Connor Road North of Perinton Park, 6 feet 7" North of curve/15 mph signs.



**NY14121KL**

NY14121KL Effective 06/23/2014 to 12/31/2024

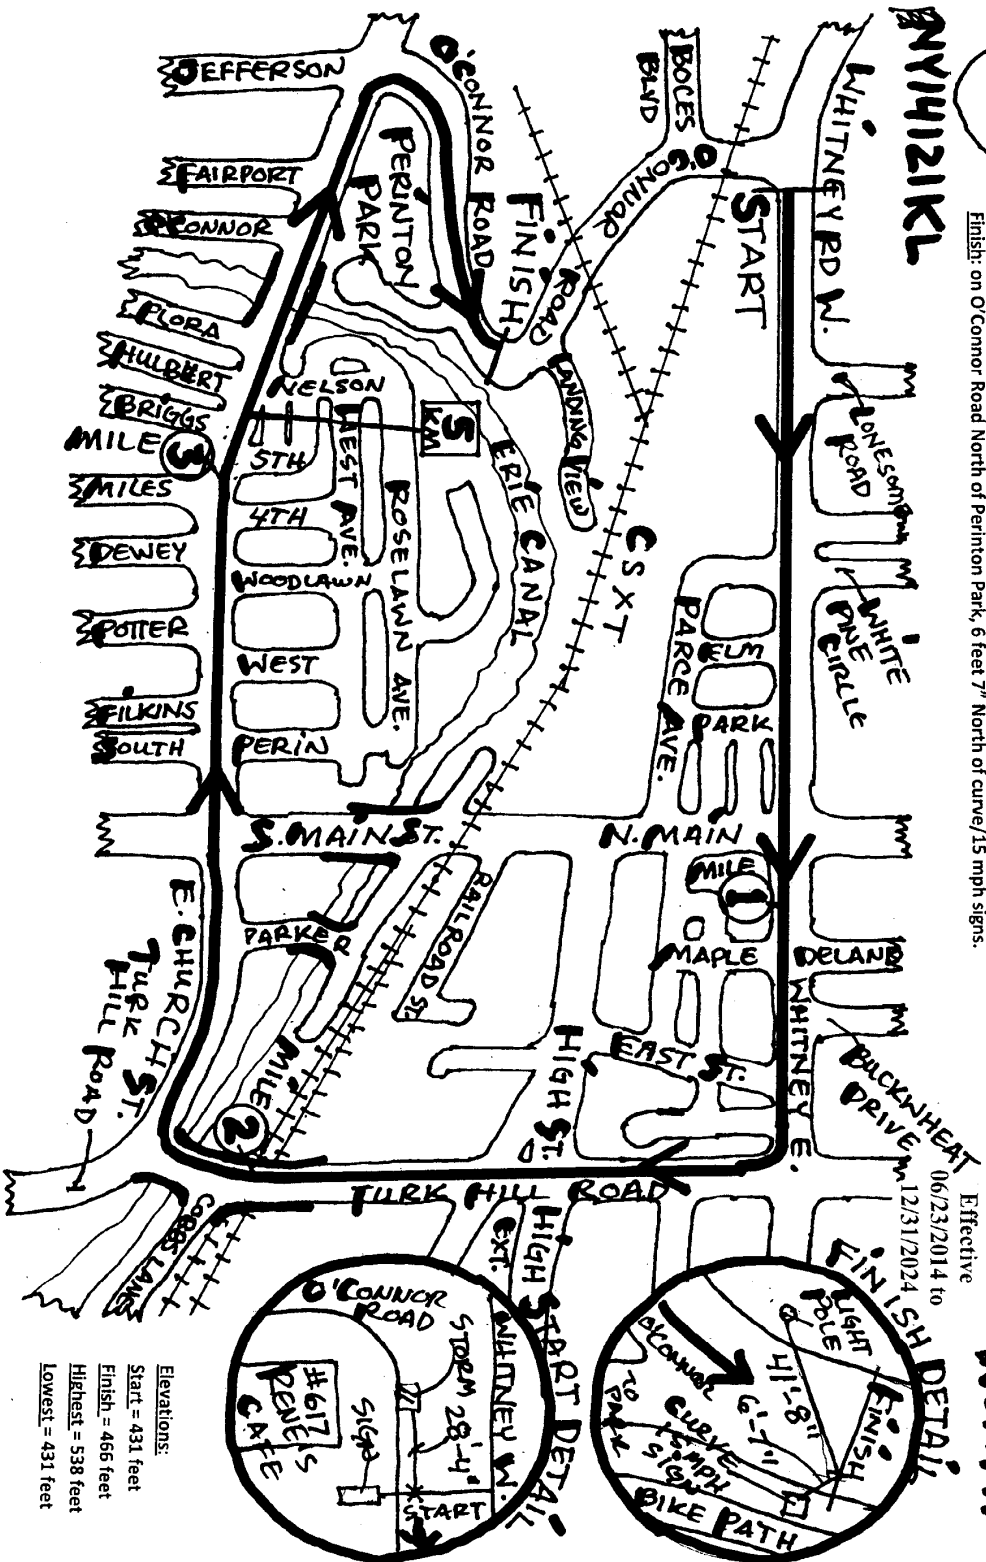

Elevations:  
 Start = 431 feet  
 Finish = 466 feet  
 Highest = 538 feet  
 Lowest = 431 feet



**Road Running Technical Council**  
**USA Track & Field**  
**Measurement Certificate**



Name of the course YellowJacket Racing Course #704 Distance 4 Mile  
 Location (state) New York (city) Fairport  
 Type of course: road race  calibration  track  Configuration: loop  
 Type of surface: paved 100 % dirt \_\_\_\_\_ % gravel \_\_\_\_\_ % grass \_\_\_\_\_ % track \_\_\_\_\_ %  
 Elevation (meters above sea level) Start 131 Finish 142 Highest 164 Lowest 131  
 Straight line distance between start & finish 730 meters Drop -1.7 m/km Separation 11.3 %  
 Measured by (name, address, phone & e-mail) Kevin P. Lucas, 94 South Ridge Trail, Fairport, NY  
14450-3843, 585-421-9626, & k\_p\_lucas@frontiernet.net  
 Race contact (name, address, phone & e-mail) Boots, c/o YellowJacket Racing, 155 Culver Road,  
Suite 110, Rochester, NY 14620, 585-732-1090  
 Measuring Methods: bicycle  steel tape  electronic distance meter   
 Number of measurements of entire course: 2 Date(s) when course measured: June 22, 2014  
 Race date: July 4, 2014 Course certification effective date: June 23 2014  
 Certification code: NY14121KL

Notice to Race Director: Use this Certification Code in *all* public announcements relating to your race.

***Be It Officially Noted That***

Based on examination of data provided by the above named measurer, the course described above and in the map attached is hereby certified as reasonably accurate in measurement according to the standards adopted by the Road Running Technical Council. If *any* changes are made to the course, this certification becomes void, and the course must then be recertified.

**Verification of Course** — In the event a National Open Record is set on this course, or at the discretion of USA Track & Field, a verification remeasurement may be required to be performed by a member of the Road Running Technical Council. If such a remeasurement shows the course to be short, then all pending records will be rejected and the course certification will be cancelled.

***This certification expires on December 31 in the year*** **2024**

**AS NATIONALLY CERTIFIED BY:**

\_\_\_\_\_ Date: June 23, 2014

Kevin P. Lucas – USATF/RRTC National Certifier  
 94 South Ridge Trail, Fairport, NY 14450-3843, 585-421-9626, & k\_p\_lucas@frontiernet.net