

Yellowjacket Racing Course 704 - Perinton Park, Fairport, New York

Measured on: June 22, 2014 - By: Kevin P. Lucas - 585-421-9626

Measured Marks: Start: at #617 Whitney Road W., at René's Café sign and 28 feet 4" East of storm drain.

- 1 Mile: at #1043 Whitney Road E., 22 feet East of telephone pole at West side of driveway.
- 2 Mile: on Turk Hill Road South of RR overpass, 58 feet 7" South of concrete bridge overpass.
- 3 Mile: at #106 W. Church Street, 12 feet 11" West of light pole at West side of driveway.
- 5 km: at #130 W. Church Street, 24 feet 3" East of light pole at Nelson Street.
- Finish: on O'Connor Road North of Perinton Park, 6 feet 7" North of curve/15 mph signs.




NY14121KL NORTH

Effective

06/23/2014 to

12/31/2024

NY14121KL

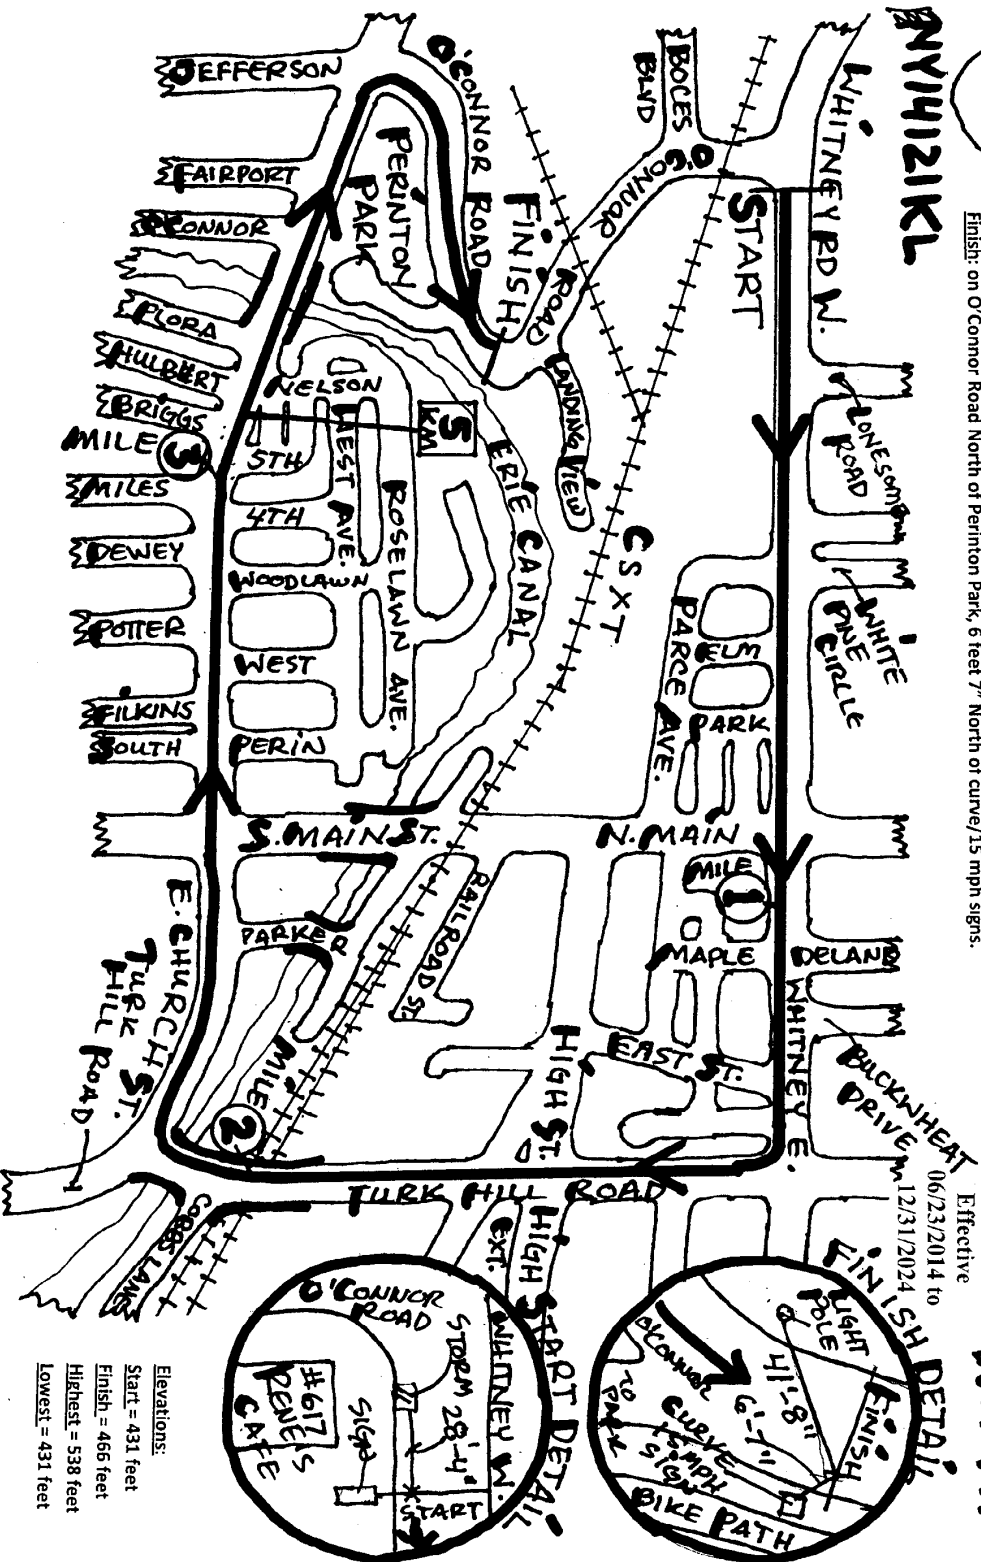

Elevations:
Start = 431 feet
Finish = 466 feet
Highest = 538 feet
Lowest = 431 feet



Road Running Technical Council
USA Track & Field
Measurement Certificate



Name of the course YellowJacket Racing Course #704 Distance 4 Mile
Location (state) New York (city) Fairport
Type of course: road race ☒ calibration ☐ track ☐ Configuration: loop
Type of surface: paved 100 % dirt % gravel % grass % track %
Elevation (meters above sea level) Start 131 Finish 142 Highest 164 Lowest 131
Straight line distance between start & finish 730 meters Drop -1.7 m/km Separation 11.3 %
Measured by (name, address, phone & e-mail) Kevin P. Lucas, 94 South Ridge Trail, Fairport, NY
14450-3843, 585-421-9626, & k_p_lucas@frontiernet.net
Race contact (name, address, phone & e-mail) Boots, c/o YellowJacket Racing, 155 Culver Road,
Suite 110, Rochester, NY 14620, 585-732-1090
Measuring Methods: bicycle ☒ steel tape ☐ electronic distance meter ☐
Number of measurements of entire course: 2 Date(s) when course measured: June 22, 2014
Race date: July 4, 2014 Course certification effective date: June 23 2014
Certification code: NY14121KL

Notice to Race Director: Use this Certification Code
in *all* public announcements relating to your race.

Be It Officially Noted That

Based on examination of data provided by the above named measurer, the course described above and in the map attached is hereby certified as reasonably accurate in measurement according to the standards adopted by the Road Running Technical Council. If *any* changes are made to the course, this certification becomes void, and the course must then be recertified.

Verification of Course — In the event a National Open Record is set on this course, or at the discretion of USA Track & Field, a verification remeasurement may be required to be performed by a member of the Road Running Technical Council. If such a remeasurement shows the course to be short, then all pending records will be rejected and the course certification will be cancelled.

This certification expires on December 31 in the year **2024**

AS NATIONALLY CERTIFIED BY:

Date: June 23, 2014

Kevin P. Lucas – USATF/RRTC National Certifier
94 South Ridge Trail, Fairport, NY 14450-3843, 585-421-9626, & k_p_lucas@frontiernet.net