

# Mr. Ed's Superbowl Warm-Up 5 km - Middleport, New York

Measured on: May 29, 2014 - By: Kevin P. Lucas - 585-421-9626 - Originally Certified NY14114KL



## Measured Marks & Elevations:

- Start @ 504 feet elev: on Mill Street at N. Hartland Street, at power pole #NM 5 on South side of road.
- 1 Mile @ 483 feet elev: 523 feet (160 meters) East of mailbox at #9488 Townline Road on South side of road.
- 2 Mile @ 514 feet elev: East of Peet Street Bridge, 97 feet 4" East of #10 marker on South side of Canal path.
- 3 Mile @ 501 feet elev: at #22 Mill Street, 32 feet 7" East of yellow fire hydrant on South side of road.
- Finish @ 509 feet elev: at #6 Mill Street, 35 feet 3" East of power pole #102 on South side of road.



NY14900KL

Effective  
01/23/2016 to  
12/31/2024

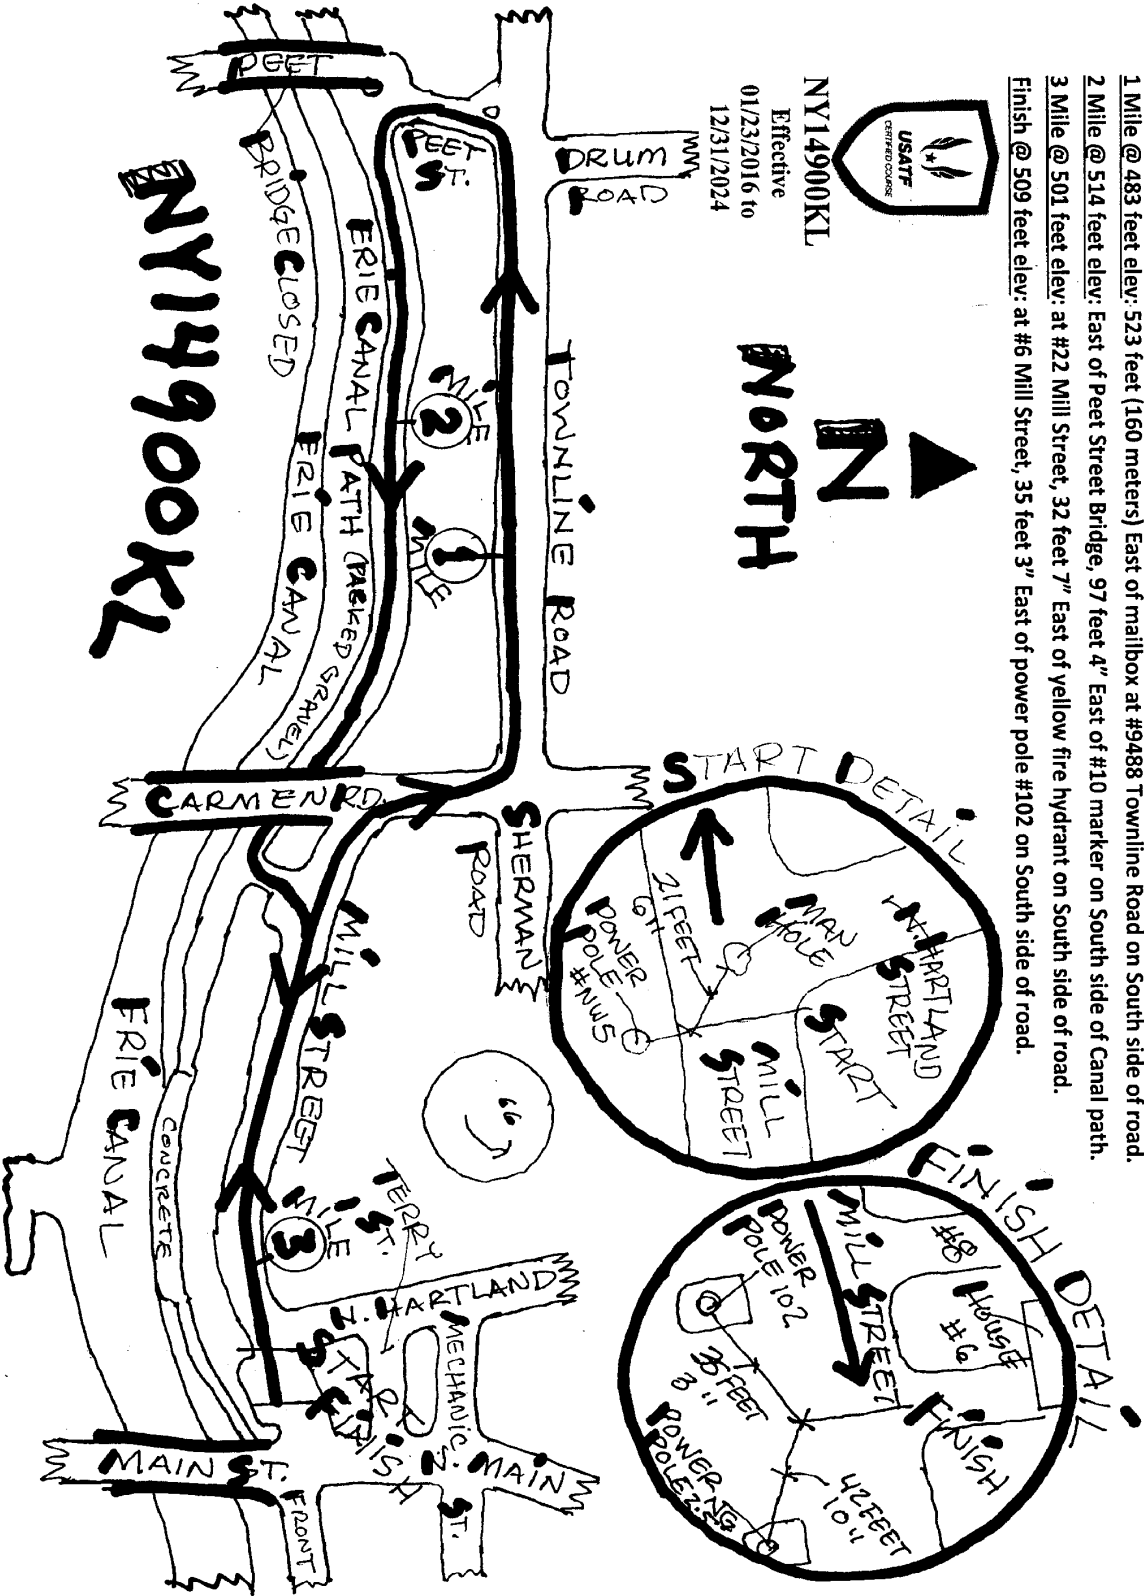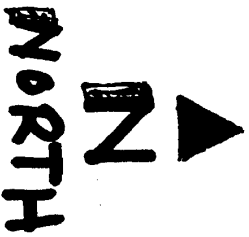

NY14900KL



**Road Running Technical Council  
USA Track & Field  
Measurement Certificate**



Name of the course Mr. Ed's Superbowl Warm-Up 5 km Distance 5 km  
 Location (state) New York (city) Middleport  
 Type of course: road race  calibration course  track   
 Measuring methods: bicycle  steel tape  electronic distance meter   
 Measured by (name, address, phone & e-mail) Kevin P. Lucas, 94 South Ridge Trail, Fairport, NY  
14450-3843, 585-421-9626 & k\_p\_lucas@frontiernet.net  
 Race contact (name, address, phone & e-mail) Jack Kiebala, 113 Starling Drive, Medina, NY  
14103-1333, 585-749-3765  
 Date(s) when course measured: May 29, 2014  
 Number of measurements of entire course: 2 Course Configuration: keyhole  
 Elevation (meters above sea level) Start 154 Finish 155 Highest 158 Lowest 145  
 Straight line distance between start & finish 83 meters Drop -0.2 m/km Separation 1.67 %  
 Type of surface: paved 65 % dirt      % gravel 35 % grass      % track      %  
 Effective date of certification: January 23, 2016 Certification code: NY14900KL

Originally Certified NY14114KL

Notice to Race Director: Use this Certification Code in *all* public announcements relating to your race.

***Be It Officially Noted That***

Based on examination of data provided by the above named measurer, the course described above and in the map attached is hereby certified as reasonably accurate in measurement according to the standards adopted by the Road Running Technical Council. If *any* changes are made to the course, this certification becomes void, and the course must then be recertified.

**Verification of Course** — In the event a National Open Record is set on this course, or at the discretion of USA Track & Field, a verification remeasurement may be required to be performed by a member of the Road Running Technical Council. If such a remeasurement shows the course to be short, then all pending records will be rejected and the course certification will be cancelled.

***This certification expires on December 31 in the year*** **2024**

**AS NATIONALLY CERTIFIED BY:**

\_\_\_\_\_ Date: January 23, 2016

Kevin P. Lucas – USATF/RRTC Certifier  
 94 South Ridge Trail, Fairport, NY 14450-3843, 585-421-9626 & k\_p\_lucas@frontiernet.net