



NY15107KL


Effective
04/15/2015 to
12/31/2025

Ogden 5 km, Pineway Ponds Park, Spencerport, New York

Measured on: April 14, 2015 - By: Kevin P. Lucas - 585-421-9626

Measured Marks:

- Start: on Pineway Ponds Park Road just East of Canal Days Lodge, 46 feet 10" West of power pole 12B-6 on South side of road
 - 1 Mile: at #165 Amity Street, 33 feet 7" West of power pole OTC 18 at corner of Evergreen & Amity
 - 2 Mile: on Trimmer Road about 60 meters off Canal Bridge, 20 feet South of One Lane Bridge sign on North side of road
 - 3 Mile: on Pineway Ponds Park Road just North of Boetcher Lodge, 27 feet 8" East of power pole 12B-12 on East side of road
 - Finish: on Pineway Ponds Park Road at Canal Days Lodge, at power pole 12B-8 on South side of road
- Elevations: Start = 483 feet, Finish = 488 feet, Highest = 527 feet, & Lowest = 483 feet

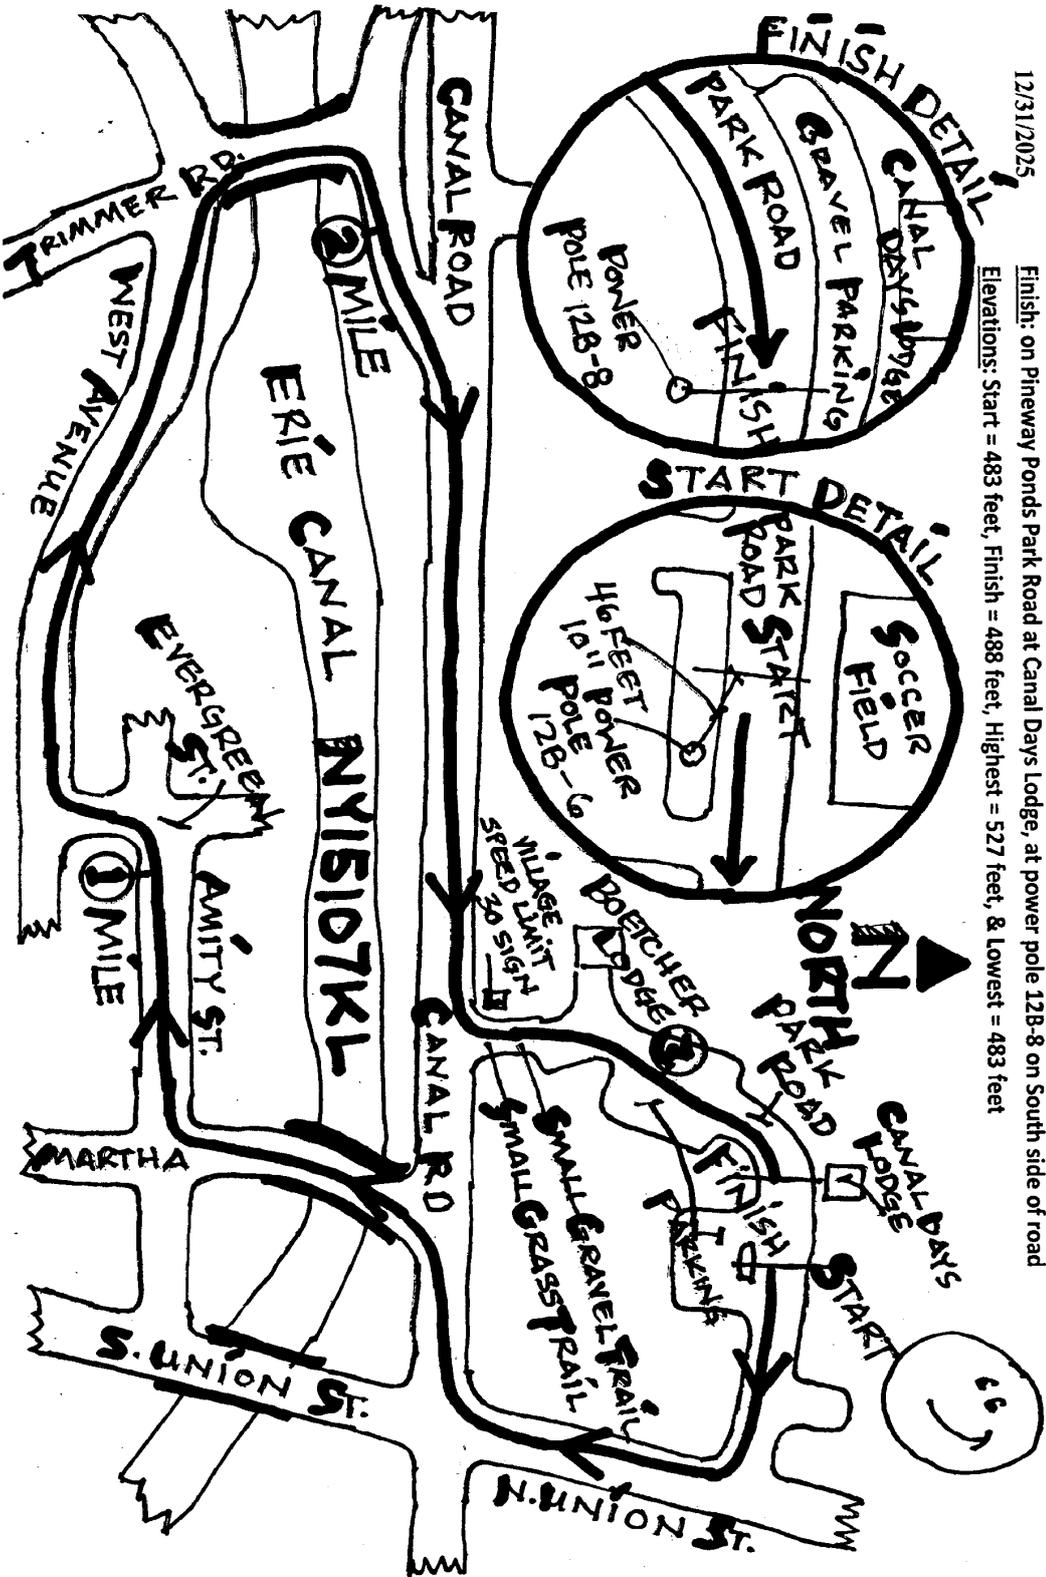



**Road Running Technical Council
USA Track & Field
Measurement Certificate**



Name of the course Ogden 5 km Distance 5 km
 Location (state) New York (city) Spencerport
 Type of course: road race calibration track Configuration: loop
 Type of surface: paved 98 % dirt % gravel <1 % grass <1 % track %
 Elevation (meters above sea level) Start 147 Finish 149 Highest 161 Lowest 147
 Straight line distance between start & finish 92 meters Drop -0.4 m/km Separation 1.8 %
 Measured by (name, address, phone & e-mail) Kevin P. Lucas, 94 South Ridge Trail, Fairport, NY
14450-3843, 585-421-9626, & k_p_lucas@frontiernet.net
 Race contact (name, address, phone & e-mail) Andrea Hansen, c/o Town of Ogden Parks & Recreation,
269 Ogden Center Road, Spencerport, NY 14559-2076, 585-617-6174
 Measuring Methods: bicycle steel tape electronic distance meter
 Number of measurements of entire course: 2 Date(s) when course measured: April 14, 2015
 Race date: September 26, 2015 Course certification effective date: April 15, 2015
 Certification code: NY15107KL

Notice to Race Director: Use this Certification Code in *all* public announcements relating to your race.

Be It Officially Noted That

Based on examination of data provided by the above named measurer, the course described above and in the map attached is hereby certified as reasonably accurate in measurement according to the standards adopted by the Road Running Technical Council. If *any* changes are made to the course, this certification becomes void, and the course must then be recertified.

Verification of Course — In the event a National Open Record is set on this course, or at the discretion of USA Track & Field, a verification remeasurement may be required to be performed by a member of the Road Running Technical Council. If such a remeasurement shows the course to be short, then all pending records will be rejected and the course certification will be cancelled.

This certification expires on December 31 in the year **2025**

AS NATIONALLY CERTIFIED BY:

_____ Date: April 15, 2015

Kevin P. Lucas – USATF/RRTC Certifier
 94 South Ridge Trail, Fairport, NY 14450-3843, 585-421-9626, & k_p_lucas@frontiernet.net