



# Jenny Kuzma Memorial Bergen 5 km, Bergen, New York

Measured on: July 15, 2015 - By: Kevin P. Lucas - 585-421-9626

**NY15128KL**

Effective  
07/16/2015 to  
12/31/2025

### Measured Marks:

**Start @ 642 ft elev:** at #15 Parkview Dr, 49 feet 2" West of mailbox #15 on North side of road

**1 km @ 626 ft elev:** at #61 Buffalo Rd, 71 feet 2" East of mailbox #61 on North side of road

**1 Mile:** at #55 Rochester St, 28 feet 10" East of power pole #BE11 on North side of road

**2 km @ 602 ft elev:** at #14 Leroy St, 15 feet 2" South of power pole #BE15B on West side of road

**3 km @ 620 ft elev:** at #13 Clinton St, 7 feet 5" North of mailbox #13 on East side of road


**2 Mile @ 614 ft elev:** at #30 Rochester St, 38 feet West of mailbox #37 on South side of road

**4 km:** East of #61 Buffalo Rd, 19 feet 9" West of West 33 road sign on North side of road

**3 Mile:** on Parkview Dr at Hickory Park entrance, 55 feet 6" East of Park hours sign

**Finish @ 635 ft elev:** in Hickory Park on grass, 205 feet West of PK Nail on paved trail

42 feet 1" East of power/light pole #BE10A at park shelter

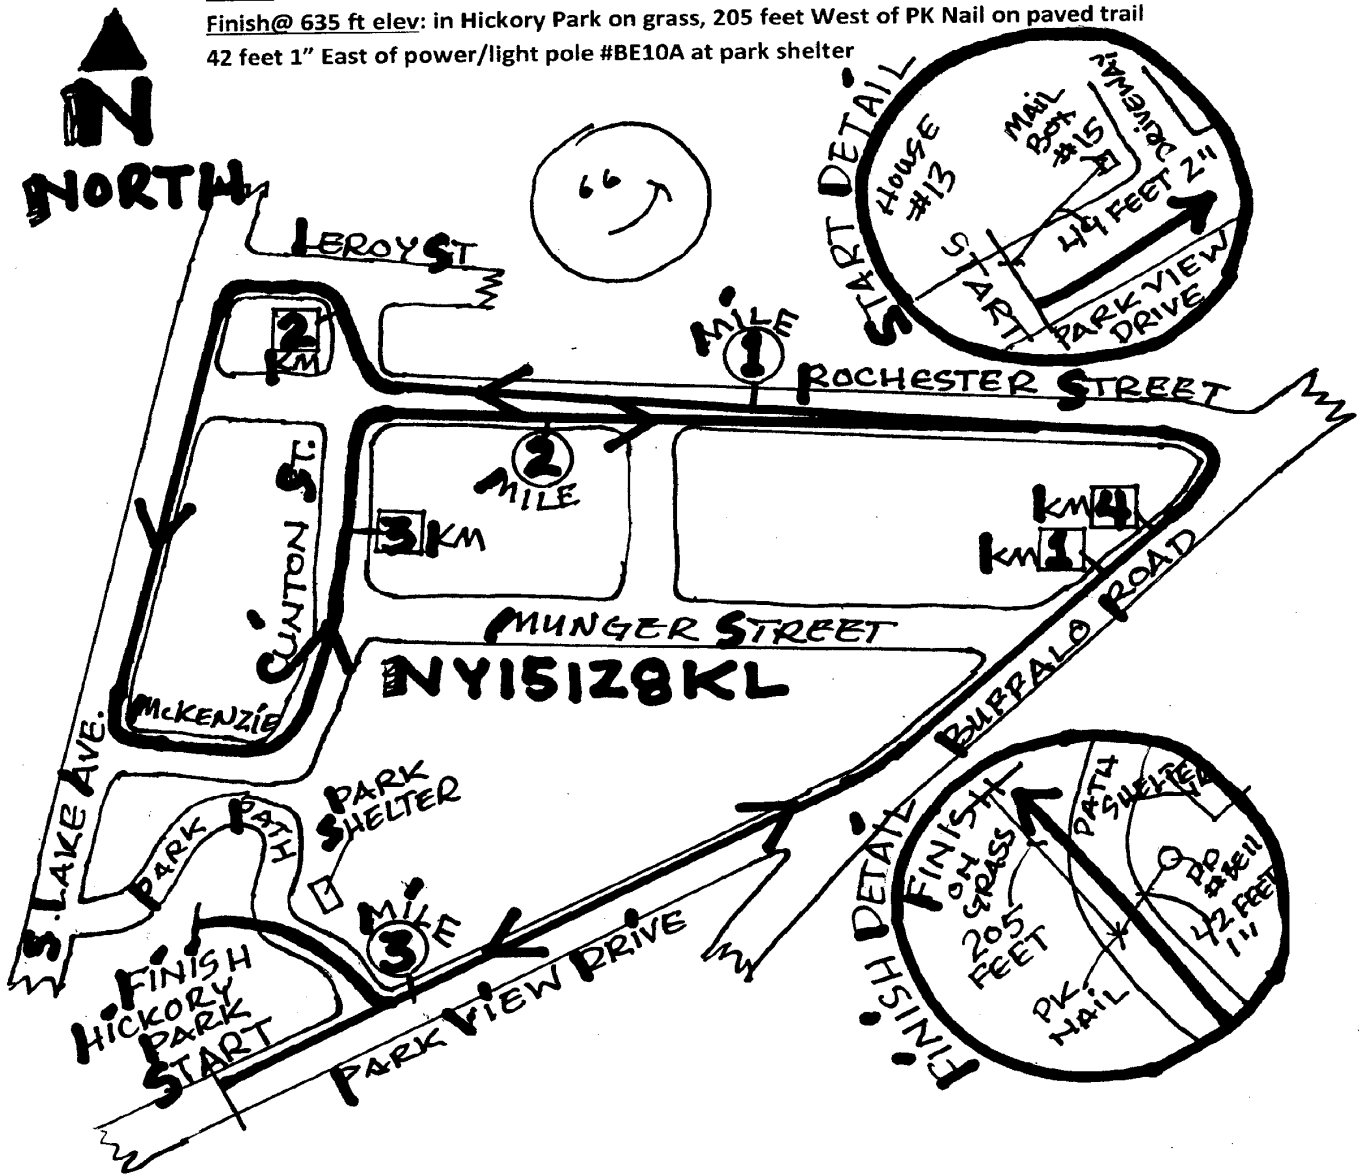



**Road Running Technical Council**  
**USA Track & Field**  
**Measurement Certificate**



Name of the course Jenny Kuzma Memorial Bergen 5 km Distance 5 km  
 Location (state) New York (city) Bergen  
 Type of course: road race  calibration  track  Configuration: keyhole  
 Type of surface: paved 98 % dirt      % gravel 1 % grass 1 % track      %  
 Elevation (meters above sea level) Start 196 Finish 194 Highest 196 Lowest 103  
 Straight line distance between start & finish 185 meters Drop 0.4 m/km Separation 3.7 %  
 Measured by (name, address, phone & e-mail) Kevin P. Lucas, 94 South Ridge Trail, Fairport, NY  
14450-3843, 585-421-9626, & k\_p\_lucas@frontiernet.net  
 Race contact (name, address, phone & e-mail) Eric Boyce, 6960 Old State Road,  
Bergen, NY 14416, 585-944-1142  
 Measuring Methods: bicycle  steel tape  electronic distance meter   
 Number of measurements of entire course: 2 Date(s) when course measured: July 15, 2015  
 Race date: August 8, 2015 Course certification effective date: July 16, 2015  
 Certification code: NY15128KL

Notice to Race Director: Use this Certification Code in *all* public announcements relating to your race.

***Be It Officially Noted That***

Based on examination of data provided by the above named measurer, the course described above and in the map attached is hereby certified as reasonably accurate in measurement according to the standards adopted by the Road Running Technical Council. If *any* changes are made to the course, this certification becomes void, and the course must then be recertified.

**Verification of Course** — In the event a National Open Record is set on this course, or at the discretion of USA Track & Field, a verification remeasurement may be required to be performed by a member of the Road Running Technical Council. If such a remeasurement shows the course to be short, then all pending records will be rejected and the course certification will be cancelled.

***This certification expires on December 31 in the year*** **2025**

**AS NATIONALLY CERTIFIED BY:**

Date: July 16, 2015

Kevin P. Lucas – USATF/RRTC Certifier  
 94 South Ridge Trail, Fairport, NY 14450-3843, 585-421-9626, & k\_p\_lucas@frontiernet.net