

# Oak Tree 5 km

Geneseo High School, Geneseo, New York

Measured on: March 27, 2016

By: Kevin P. Lucas – 585-421-9626



NY16111KL

Effective

03/29/2016 to

12/31/2026

**Measured Marks & Elevations:**

Start @ 778 feet elev: on Avon Road North of Westview Crescent, 15 feet 7" North of speed limit 30 sign &

87 feet 4" North of man hole, both on West side of road at mile marker 39-4206-1100


1 Mile @ 786 feet elev: on Center St at Second St intersection, 16 feet 9" West on man hole cover

2 Mile @ 779 feet elev: at house #17 North St, 21 feet West of power pole RGE 5AN on North side of road

3 Mile @ 779 feet elev: on Geneseo HS track (West side), 22 feet 2" North of storm drain on infield

Finish @ 785 feet elev: on Geneseo HS track (East side), at yellow hash marks South end of bleachers,

63 feet North of storm drain on infield & 102 feet 5" South of storm drain on infield

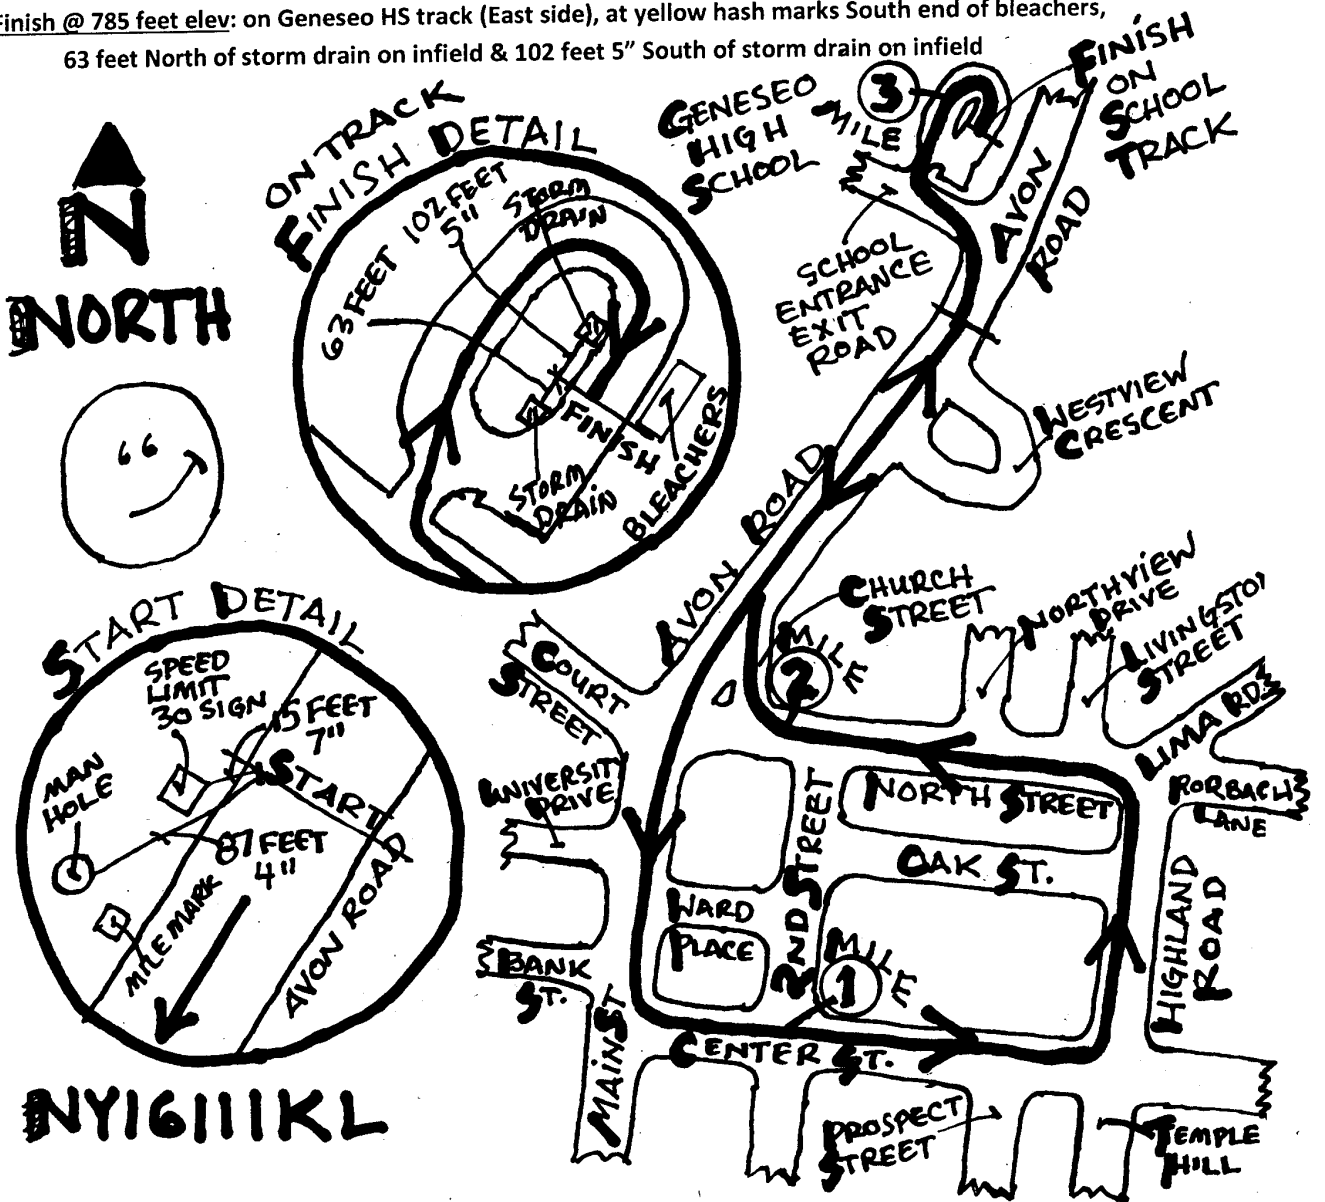



**Road Running Technical Council  
USA Track & Field**

# Measurement Certificate



Name of the course Oak Tree 5 km Distance 5 km  
 Location (state) New York (city) Geneseo  
 Type of course: road race  calibration course  track   
 Measuring methods: bicycle  steel tape  electronic distance meter   
 Measured by (name, address, phone & e-mail) Kevin P. Lucas, 94 South Ridge Trail, Fairport, NY  
14450-3843, 585-421-9626 & k\_p\_lucas@frontiernet.net  
 Race contact (name, address, phone & e-mail) Benjamin Gajewski, c/o Genesee Valley Conservancy, Inc.,  
PO Box 73 (One Main Street), Geneseo, NY 14454-0073, 585-243-2190  
 Date(s) when course measured: March 27, 2016  
 Number of measurements of entire course: 2 Course Configuration: keyhole  
 Elevation (meters above sea level) Start 237.2 Finish 239.3 Highest 265.5 Lowest 234.1  
 Straight line distance between start & finish 430 meters Drop -0.42 m/km Separation 8.6 %  
 Type of surface: paved 94 % dirt \_\_\_\_\_ % gravel \_\_\_\_\_ % grass \_\_\_\_\_ % track 6 %  
 Effective date of certification: March 29, 2016 Certification code: NY16111KL

Notice to Race Director: Use this Certification Code in *all* public announcements relating to your race.

## Be It Officially Noted That

Based on examination of data provided by the above named measurer, the course described above and in the map attached is hereby certified as reasonably accurate in measurement according to the standards adopted by the Road Running Technical Council. If *any* changes are made to the course, this certification becomes void, and the course must then be recertified.

**Verification of Course** — In the event a National Open Record is set on this course, or at the discretion of USA Track & Field, a verification remeasurement may be required to be performed by a member of the Road Running Technical Council. If such a remeasurement shows the course to be short, then all pending records will be rejected and the course certification will be cancelled.

**This certification expires on December 31 in the year** **2026**

**AS NATIONALLY CERTIFIED BY:**

\_\_\_\_\_ Date: March 29, 2016

Kevin P. Lucas – USATF/RRTC Certifier  
 94 South Ridge Trail, Fairport, NY 14450-3843, 585-421-9626 & k\_p\_lucas@frontiernet.net