

Stiletto & Sneaker 5 km – Batavia, New York

Measured on: August 18, 2016

By: Kevin P. Lucas – 585-421-9626



NY16125KL
Effective
08/20/2016 to
12/31/2026

Measured Marks & Elevations:

Start @ 900 feet elev: on North Street East of Vine Street, 75 feet East of power pole #45 &


136 feet West of power pole #46, both on North side of road

1 Mile @ 900 feet elev: on Washington Street at State Street, 8 feet 6" West of stop sign on South side of road

2 Mile @ 908 feet elev: at #244 State Street, 44 feet 2" South of power pole #34 on East side of road

3 Mile @ 900 feet elev: at #177 Vine Street, 23 feet 6" South pedestrian walk sign on West side of road

Finish @ 900 feet elev: at YWCA #301 North St, at power pole #72-1 & 31 feet 3" East of storm drain, both on North side of road

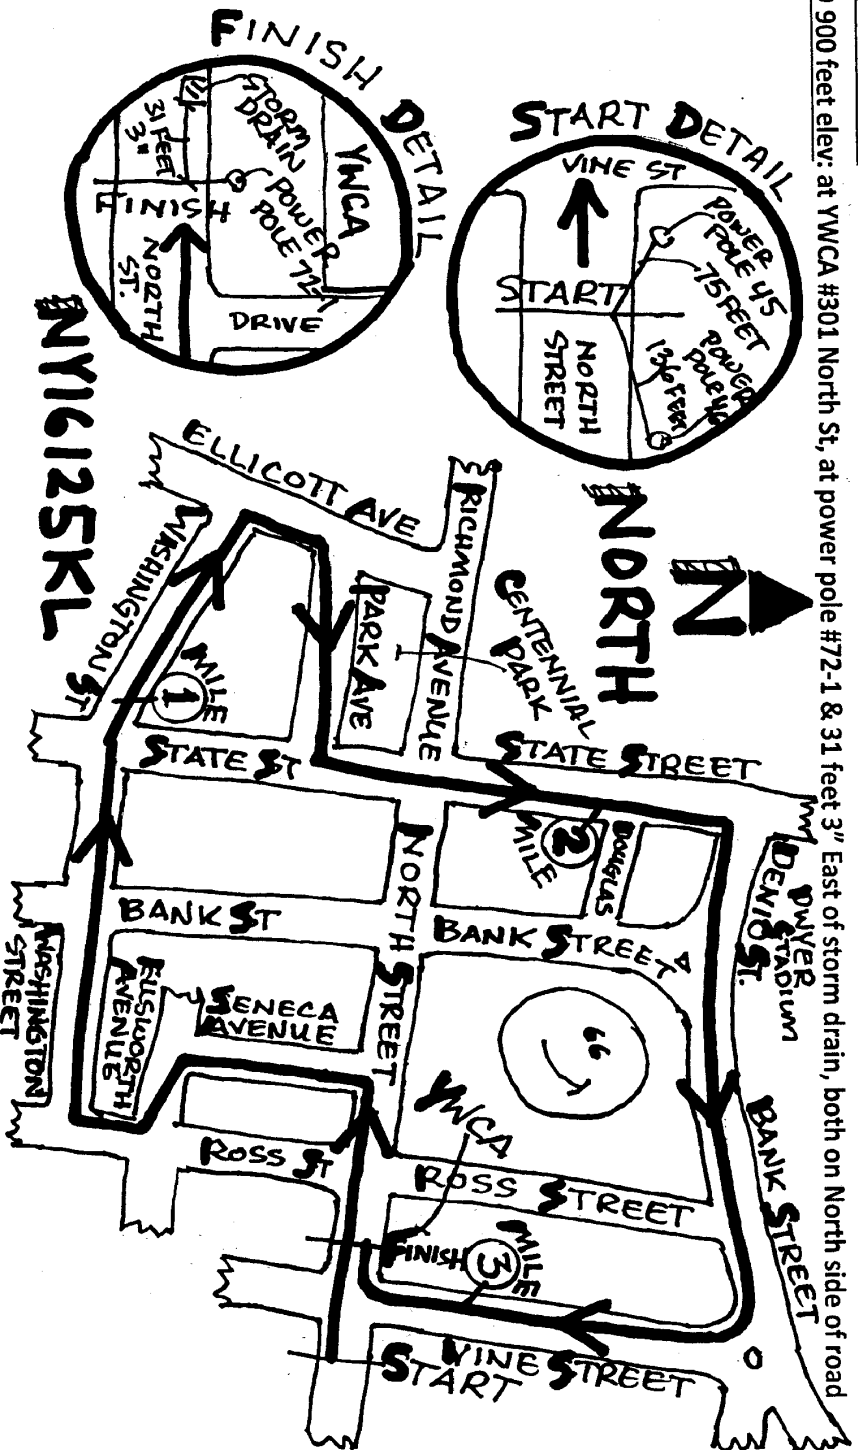

NY16125KL



**Road Running Technical Council
USA Track & Field**

Measurement Certificate



Name of the course Stiletto & Sneaker 5 km Distance 5 km
Location (state) New York (city) Batavia
Type of course: road race ☒ calibration course ☐ track ☐
Measuring methods: bicycle ☒ steel tape ☐ electronic distance meter ☐
Measured by (name, address, phone & e-mail) Kevin P. Lucas, 94 South Ridge Trail, Fairport, NY
14450-3843, 585-421-9626 & lucasmeasurement@gmail.com
Race contact (name, address, phone & e-mail) Joanne Beck, c/o YWCA of Genesee County,
301 North Street, Batavia, NY 14020-1603, 585-343-5808
Date(s) when course measured: August 18, 2016
Number of measurements of entire course: 2 Course Configuration: loop
Elevation (meters above sea level) Start 274.3 Finish 274.3 Highest 281.3 Lowest 272.5
Straight line distance between start & finish 118 meters Drop 0 m/km Separation 2.4 %
Type of surface: paved 100 % dirt % gravel % grass % track %
Effective date of certification: August 20, 2016 Certification code: NY16125KL

Notice to Race Director: Use this Certification Code
in *all* public announcements relating to your race.

Be It Officially Noted That

Based on examination of data provided by the above named measurer, the course described above and in the map attached is hereby certified as reasonably accurate in measurement according to the standards adopted by the Road Running Technical Council. If *any* changes are made to the course, this certification becomes void, and the course must then be recertified.

Verification of Course — In the event a National Open Record is set on this course, or at the discretion of USA Track & Field, a verification remeasurement may be required to be performed by a member of the Road Running Technical Council. If such a remeasurement shows the course to be short, then all pending records will be rejected and the course certification will be cancelled.

This certification expires on December 31 in the year **2026**

US NATIONALLY CERTIFIED BY:

Date: August 20, 2016

Kevin P. Lucas – USATF/RRTC Certifier
94 South Ridge Trail, Fairport, NY 14450-3843, 585-421-9626 & lucasmeasurement@gmail.com