

Rochester Mile – Rochester, New York

Measured on: July 2, 2017 - Certified Mile & Loop (0.9258432 miles)

By: Kevin P. Lucas – lucasmeasurement@gmail.com



NY17116KL


Effective

07/06/2017 to

12/31/2027

Measured Marks & Elevations:

- Start @ 532 feet elevation: on Court Street West of Saint Mary's Place, 29 feet West of traffic light pole & 4 feet 7" West of traffic signal box, both on South side of road
- 800 meters to go @ 502 feet elevation: on W. Main Street West of Exchange Blvd., 26 feet 6" West of light pole #1 on South side of road
- 500 meters to go @ 525 feet elevation: on E. Broad Street Bridge, West end of bridge, 14 feet 7" East of light pole on North side of road
- 400 meters to go @ 525 feet elevation: on E. Broad Street West of South Avenue, at twin storm drains on North side of road
- 300 meters to go @ 529 feet elevation: on E. Broad Street East of South Avenue, 88 feet East of median sign on center median
- 200 meters to go @ 534 feet elevation: on Bausch & Lomb Place North of traffic circle, 30 feet 7" North of light pole #5 on West side of road
- 100 meters to go @ 532 feet elevation: on Court Street West of Bausch & Lomb Place, 10 feet 4" East of light pole #16R on North side of road
- 50 meters to go @ 530 feet elevation: on Court Street West of Bausch & Lomb Place, 13 feet East of hydrant on North side of road
- Finish @ 529 feet elevation: at crosswalk on Court Street East of South Avenue, 23 feet 6" East of new LED light pole & center of Eastern white crosswalk line, both on North side of road

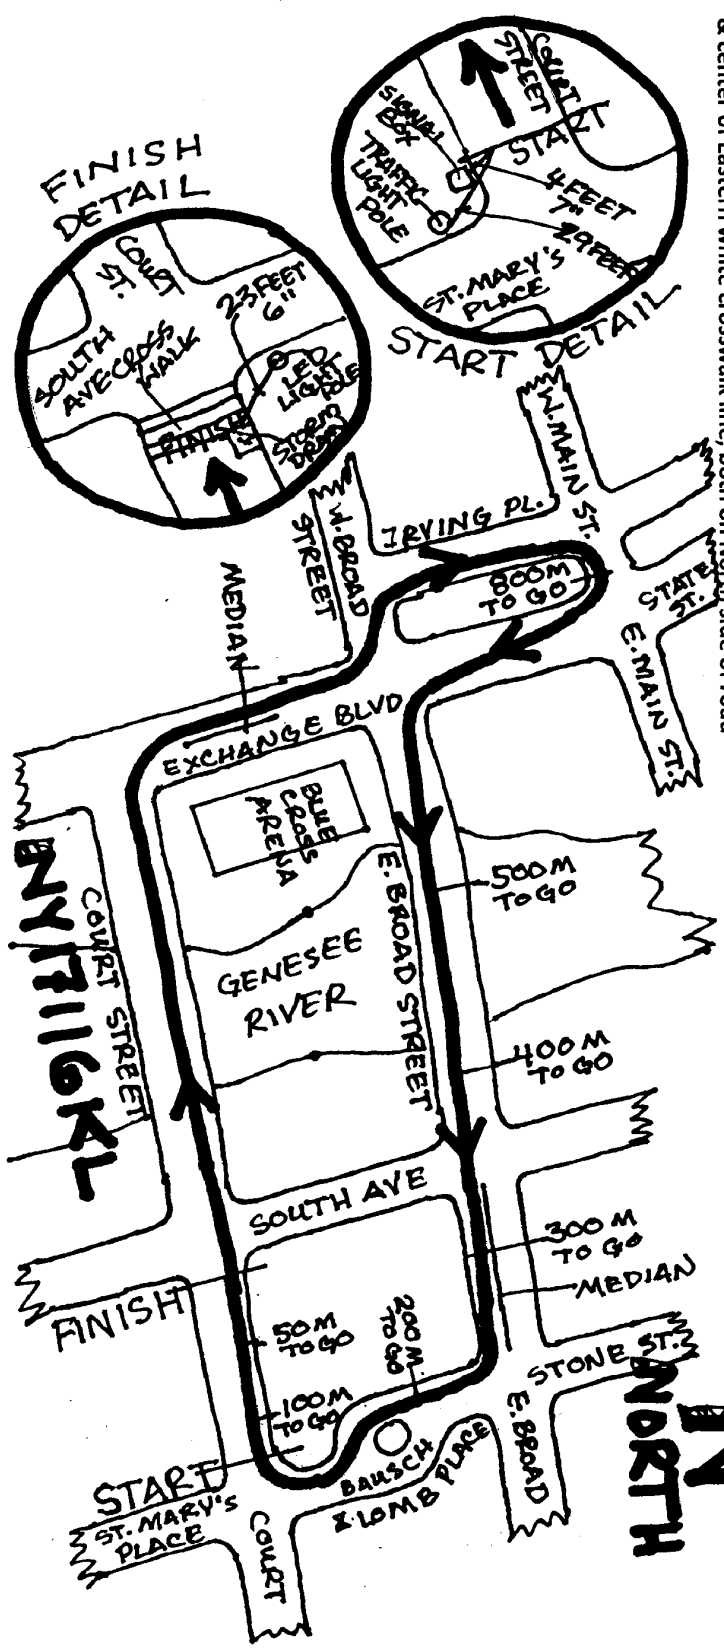



**Road Running Technical Council
USA Track & Field
Measurement Certificate**



Name of the course Rochester Mile (with certified split) Distance 1 Mile
 Location (state) New York (city) Rochester
 Type of course: road race calibration course
 Measuring method: bicycle steel tape electronic distance meter
 Measured by (name, address, phone & e-mail) Kevin P. Lucas, 94 South Ridge Trail, Fairport, NY
14450-3843, 585-421-9626 & lucasmeasurement@gmail.com
 Race contact (name, address, phone & e-mail) Scott Page, c/o Full Moon Vista Bike & Sport,
1239 University Avenue, Rochester, NY 14607-1636, 585-546-4030
 Date(s) when course measured: July 2, 2017
 Number of measurements of entire course: 2 Course Configuration: loop
 Elevation (meters above sea level) Start 162.2 Finish 161.3 Highest 162.2 Lowest 152.1
 Straight line distance between start & finish 119.4 meters Drop 0.56 m/km Separation 7.42 %
 Type of surface: paved 100 % dirt _____ % gravel _____ % grass _____ % track _____ %
 Effective date of certification: July 6, 2017 Certification code: NY17116KL

Notice to Race Director: Use this Certification Code in *all* public announcements relating to your race.

Be It Officially Noted That

Based on examination of data provided by the above named measurer, the course described above and in the map attached is hereby certified as reasonably accurate in measurement according to the standards adopted by the Road Running Technical Council. If *any* changes are made to the course, this certification becomes void, and the course must then be recertified.

Verification of Course — In the event a National Open Record is set on this course, or at the discretion of USA Track & Field, a verification remeasurement may be required to be performed by a member of the Road Running Technical Council. If such a remeasurement shows the course to be short, then all pending records will be rejected and the course certification will be cancelled.

This certification expires on December 31 in the year **2027**

AS NATIONALLY CERTIFIED BY:



Date: July 6, 2017

Kevin P. Lucas - USATF/RRTC Certifier
 94 South Ridge Trail, Fairport, NY 14450-3843, 585-421-9626 & lucasmeasurement@gmail.com
 Certified Loop: Start Elevation: Finish Elevation: Drop: Straight Line Distance Start to Finish: Separation:
 0.9258432 miles 162.2 meters 162.2 meters 0 0 0