

Lilac Run 5 km – Highland Park, Rochester, New York

Measured on: April 21, 2018

By: Kevin P. Lucas – Lucasmeasurement@gmail.com



NY18101KL
Effective
04/26/2018 to
12/31/2028

Measured Marks & Elevations:


Start/Finish @ 576 feet elevation: on Highland Ave. East of St. John's entrance/exit, 6 feet 3" West of light pole #17 & 54 feet 4" West storm drain, both on South side of road

Wide Turn at S. Clinton Ave. @ 537 feet elevation: at intersection on S. Clinton Ave. Crosswalk & Double Yellow Line for West Bound Turn Lane

1 Mile @ 527 feet elevation: on S. Clinton Ave. at Westerloe Ave., 29 feet South of storm drain on West side of road

2 Mile @ 541 feet elevation: at #991 Highland Ave., center of driveway on South side of road

3 Mile @ 569 feet elevation: at #279 Highland Ave. West of Meadowbrook Rd., 7 feet 6" East of CATV manhole cover on North side of road

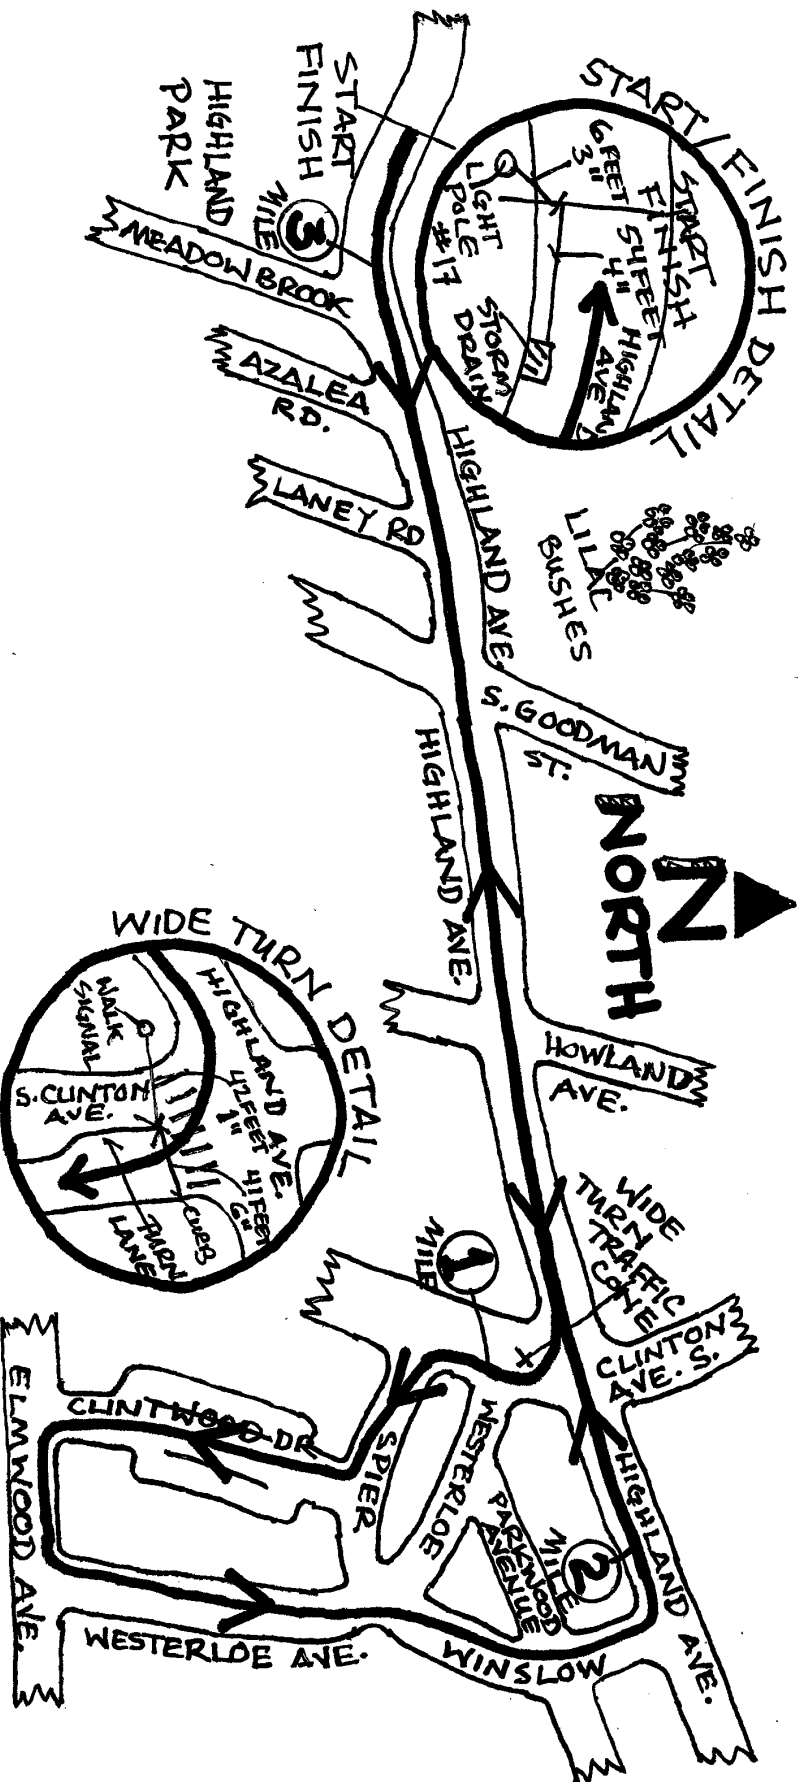



**Road Running Technical Council
USA Track & Field**

Measurement Certificate



Name of the course Lilac Run 5 km Distance 5 km
Location (state) New York (city) Rochester
Type of course: road race ☒ calibration course ☐ track ☐
Measuring methods: bicycle ☒ steel tape ☐ electronic distance meter ☐
Measured by (name, address, phone & e-mail) Kevin P. Lucas, 94 South Ridge Trail, Fairport, NY
14450-3843, 585-421-9626 & lucasmeasurement@gmail.com
Race contact (name, address, phone & e-mail) Joseph Dolce, c/o Rochester Events,
26 South Goodman Street, Rear, Rochester, NY 14607, 585-473-4482
Date(s) when course measured: April 21, 2018
Number of measurements of entire course: 2 Course Configuration: keyhole
Elevation (meters above sea level) Start 175.6 Finish 175.6 Highest 175.6 Lowest 152.4
Straight line distance between start & finish 0 meters Drop 0 m/km Separation 0 %
Type of surface: paved 100 % dirt % gravel % grass % track %
Effective date of certification: April 26, 2018 Certification code: NY18101KL

Notice to Race Director: Use this Certification Code
in **all** public announcements relating to your race.

Be It Officially Noted That

Based on examination of data provided by the above named measurer, the course described above and in the map attached is hereby certified as reasonably accurate in measurement according to the standards adopted by the Road Running Technical Council. If **any** changes are made to the course, this certification becomes void, and the course must then be recertified.

Verification of Course — In the event a National Open Record is set on this course, or at the discretion of USA Track & Field, a verification remeasurement may be required to be performed by a member of the Road Running Technical Council. If such a remeasurement shows the course to be short, then all pending records will be rejected and the course certification will be cancelled.

This certification expires on December 31 in the year **2028**

AS NATIONALLY CERTIFIED BY:

Date: April 26, 2018

Kevin P. Lucas – USATF/RRTC Certifier

94 South Ridge Trail, Fairport, NY 14450-3843, 585-421-9626 & lucasmeasurement@gmail.com