

Byron 5 km

Town of Byron Park, Byron, New York

Measured on: May 20, 2018


By: Kevin P. Lucas – lucasmmeasurement@gmail.com



NY18105KL
Effective
05/23/2018 to
12/31/2028

Measured Marks & Elevations:

- Start & Finish @ 621 feet elevation: on McElver Road at Town of Byron Park, 21 feet 6" West of power pole #3/1 with meter on it & 16 feet 9" South of sanitary sewer manhole cover, both on East side of road
- 1 Mile @ 622 feet elevation: on old roadway gravel path just West of Swamp Road gate, 15 feet East of trail marker on South side of trail
- 2 Mile @ 633 feet elevation: on old roadway gravel path, 125 feet East of turn-around mark & 370 feet West of old trail marker post on South side of trail
- Turn-around @ 635 feet elevation: on old roadway gravel path, 590 feet East of trail gate at Batavia Byron Road & 125 feet West of 2 Mile Mark
- 3 Mile @ 624 feet elevation: on cut thru road between McElver Road and Byron Holly Road, 23 feet 6" West of corner fence post on South side of road

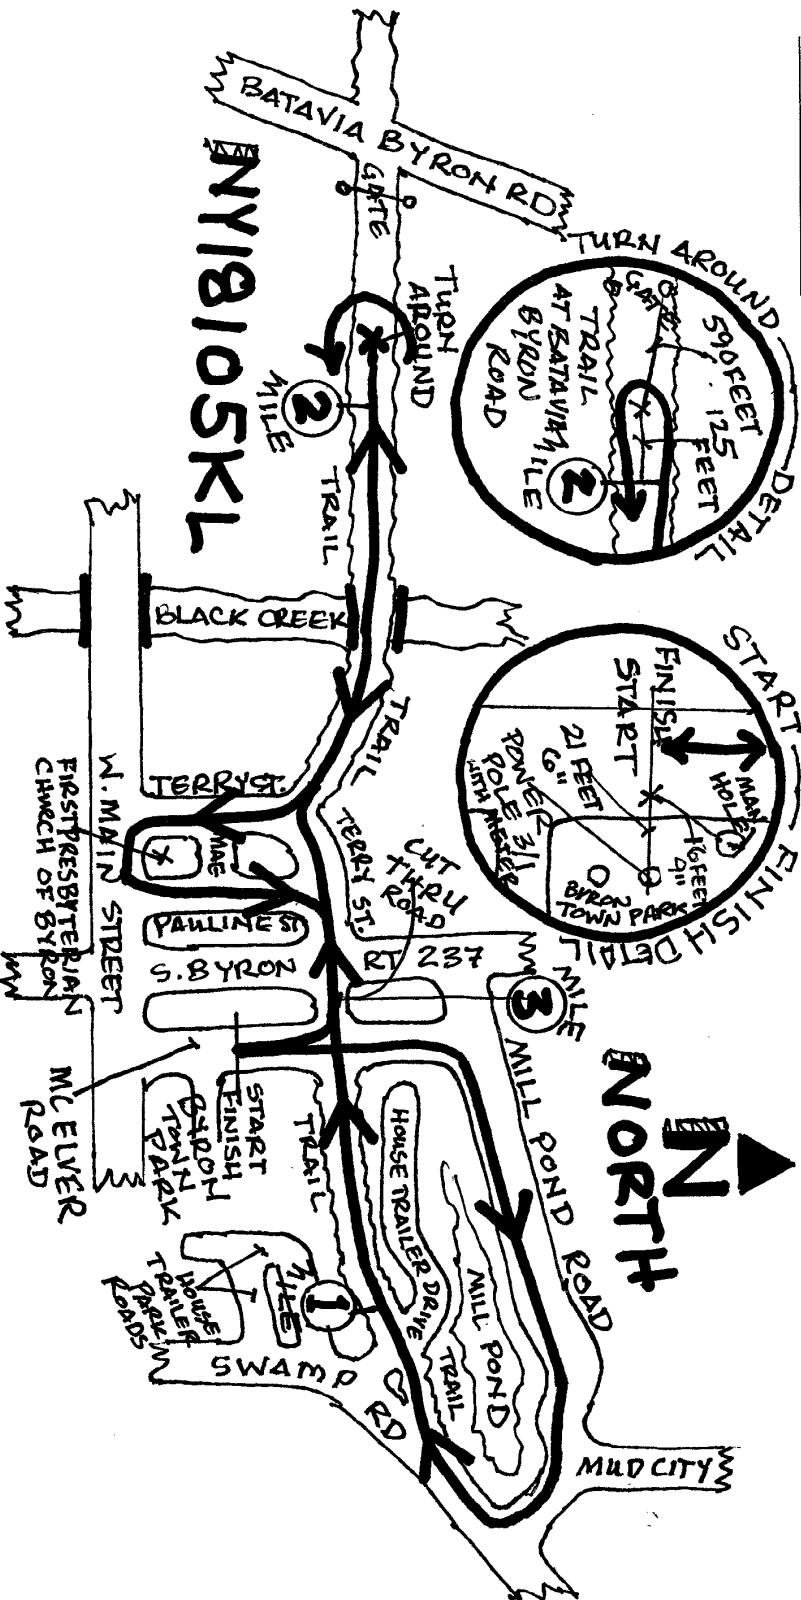



**Road Running Technical Council
USA Track & Field
Measurement Certificate**



Name of the course Byron 5 km Distance 5 km
Location (state) New York (city) Byron
Type of course: road race ☒ calibration course ☐
Measuring method: bicycle ☒ steel tape ☐ electronic distance meter ☐
Measured by (name, address, phone & e-mail) Kevin P. Lucas, 94 South Ridge Trail, Fairport, NY
14450-3843, 585-421-9626 & lucasmeasurement@gmail.com
Race contact (name, address, phone & e-mail) Brad Nickerson, c/o Byron Fire Department,
6357 Townline Road, Byron, NY 14422, 585-330-3584
Date(s) when course measured: May 20, 2018
Number of measurements of entire course: 2 Course Configuration: keyhole
Elevation (meters above sea level) Start 189.3 Finish 189.3 Highest 193.5 Lowest 183.6
Straight line distance between start & finish 0 meters Drop 0 m/km Separation 0 %
Type of surface: paved 20 % dirt 80 % gravel % grass % track %
Effective date of certification: May 23, 2018 Certification code: NY18105KL

Notice to Race Director: Use this Certification Code
in *all* public announcements relating to your race.

Be It Officially Noted That

Based on examination of data provided by the above named measurer, the course described above and in the map attached is hereby certified as reasonably accurate in measurement according to the standards adopted by the Road Running Technical Council. If *any* changes are made to the course, this certification becomes void, and the course must then be recertified.

Verification of Course — In the event a National Open Record is set on this course, or at the discretion of USA Track & Field, a verification remeasurement may be required to be performed by a member of the Road Running Technical Council. If such a remeasurement shows the course to be short, then all pending records will be rejected and the course certification will be cancelled.

This certification expires on December 31 in the year

2028

AS NATIONALLY CERTIFIED BY:

Date: May 23, 2018

Kevin P. Lucas - USATF/RRTC Certifier

94 South Ridge Trail, Fairport, NY 14450-3843, 585-421-9626 & lucasmeasurement@gmail.com