


# Tops 5 km – Williamsville, New York

Measured on: June 30, 2018

By: Kevin P. Lucas – [Lucasmeasurement@gmail.com](mailto:Lucasmeasurement@gmail.com)

## Measured Marks & Elevations:

- Start @ 691 feet elevation: at light pole #1760 on College Pkwy at Tops Bldg. & 69 feet 8" North of stop sign on East side of road
- 1 Mile @ 685 feet elevation: at house #63 Columbia Drive, 19 feet North of light pole #7 on West side of road
- 2 Mile @ 691 feet elevation: at #6075 Main Street (Anderson's Frozen Custard), 8 feet 2" West of storm drain on South side of road
- 3 Mile @ 694 feet elevation: on College Pkwy at Northrop Grumman Bldg., 89 feet South stop sign on West side of road
- Finish @ 688 feet elevation: at North side of Tops Bldg, 64 feet 2" East of storm drain & 51 feet West of light pole on North side of parking lot

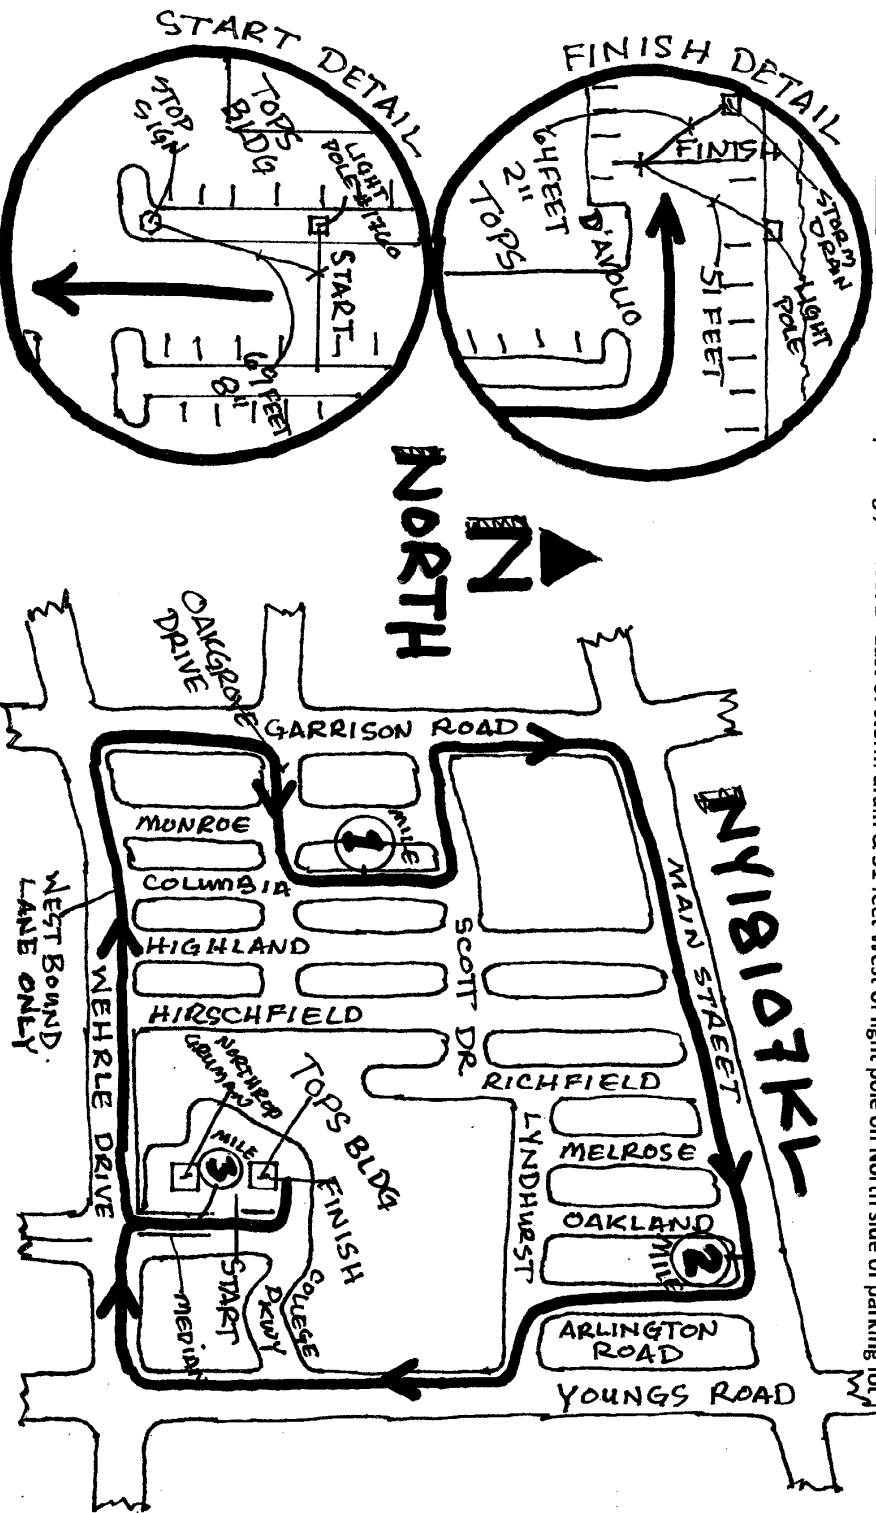

NY18107KL  
Effective  
07/03/2018 to  
12/31/2028



**Road Running Technical Council  
USA Track & Field**

# Measurement Certificate

recognized by



Name of the course Tops 5 km Distance 5 km  
Location (state) New York (city) Williamsville  
Type of course: road race ☒ calibration course ☐  
Measuring method: bicycle ☒ steel tape ☐ electronic distance meter ☐  
Measured by (name, address, phone & e-mail) Kevin P. Lucas, 94 South Ridge Trail, Fairport, NY  
14450-3843, 585-421-9626 & lucasmeasurement@gmail.com  
Race contact (name, address, phone & e-mail) Kathleen Graim, c/o Tops Markets,  
1760 Wehrle Drive, Williamsville, NY 14221-7032, 716-696-0158  
Date(s) when course measured: June 30, 2018  
Number of measurements of entire course: 2 Course Configuration: loop  
Elevation (meters above sea level) Start 210.6 Finish 209.7 Highest 212.8 Lowest 204.2  
Straight line distance between start & finish 78 meters Drop 0.18 m/km Separation 1.56 %  
Type of surface: paved 100 % dirt        % gravel        % grass        % track        %  
Effective date of certification: July 3, 2018 Certification code: NY18107KL

Notice to Race Director: Use this Certification Code  
in *all* public announcements relating to your race.

## Be It Officially Noted That

Based on examination of data provided by the above named measurer, the course described above and in the map attached is hereby certified as reasonably accurate in measurement according to the standards adopted by the Road Running Technical Council. If *any* changes are made to the course, this certification becomes void, and the course must then be recertified.

**Verification of Course** — In the event a National Open Record is set on this course, or at the discretion of USA Track & Field, a verification remeasurement may be required to be performed by a member of the Road Running Technical Council. If such a remeasurement shows the course to be short, then all pending records will be rejected and the course certification will be cancelled.

*This certification expires on December 31 in the year* **2028**

**AS NATIONALLY CERTIFIED BY:**

Date: July 3, 2018

Kevin P. Lucas - USATF/RRTC Certifier

94 South Ridge Trail, Fairport, NY 14450-3843, 585-421-9626 & lucasmeasurement@gmail.com