



Road Running Technical Council  
USA Track & Field

Measurement Certificate



Name of the course It's a Wonderful Run 5 km Distance 5 km

Location (state) NY (city) Seneca Falls

Type of course: Road Race

Measuring Methods: Bicycle

Measured By Kevin Lucas, 94 South Ridge Trail, Fairport, NY 14450, 585-421-9626, lucasmeasurement@gmail.com

Race Contact Jeff Rook, 78 W. Bayard Street, Seneca Falls, NY 13148, 315-243-6193, jeff.rook@xylem.com

Date(s) when course measured: 09/19/2021

Number of measurements of entire course: 2 Course Configuration: loop

Elevation (meters above sea level) Start 137.20 Finish 133.50 Lowest 133.50 Highest 149.40

Straight line distance between start and finish 106m Drop 0.74 m/km Separation 2.12 %

Type of surface: Paved 100 % Dirt 0 % Gravel 0 % Grass 0 % Track 0 %

Effective date of certification: September 23, 2021 Certification code: NY21002KL

Note to Race Director: Use this Certification Code in all public announcements relating to your race.

**Be It Officially Noted That**

Based on examination of data provided by the above named measurer, the course described above and in the map attached is hereby certified as reasonably accurate in measurement according to the standards adopted by the Road Running Technical Council. If any changes are made to the course, this certification becomes void, and the course must then be recertified.

**Verification of Course** --- In the event a National Open Record is set on the course, or at the discretion of USA Track & Field, a verification measurement may be required to be performed by a member of the Road Running Technical Council. If such a remeasurement shows the course to be short, then all pending records will be rejected and the course certification will be cancelled.

**This certification expires on December 31 of the year:** 2031

**AS NATIONALLY CERTIFIED BY:**

Date: September 23, 2021

Kevin Lucas - USATF/RRTC Certifier - 94 South Ridge Trail, Fairport NY 14450  
(585) 421-9626 - lucasmeasurement@gmail.com

# It's a Wonderful Run 5 km, Seneca Falls, New York

Measured on: September 19, 2021 - By: Kevin P. Lucas – [lucasmeasurement@gmail.com](mailto:lucasmeasurement@gmail.com)

Originally Certified NY09106KL

"This course was measured using the full width of the road and the Shortest Possible Route (SPR)"

### Measured Marks & Elevations:


Start @ 450 ft: at expansion joint on South side of It's a Wonderful Life Bridge (Bridge St.)

1 Mile @ 475 ft: at #37 Chapel St., 3 ft 3" West of PP#405/112 on South side of road

2 Mile @ 485 ft: at #12 Tyre Ave., 16 ft 8" East of PP#103 on South side of road

3 Mile @ 455 ft: at #113 Fall St., 14 ft 8" West of crosswalk pole on South side of road

Finish @ 438 ft: at #36 Water St., 16 ft 1" West of manhole cover & 18 ft 4" East of PP#408 on South side of road

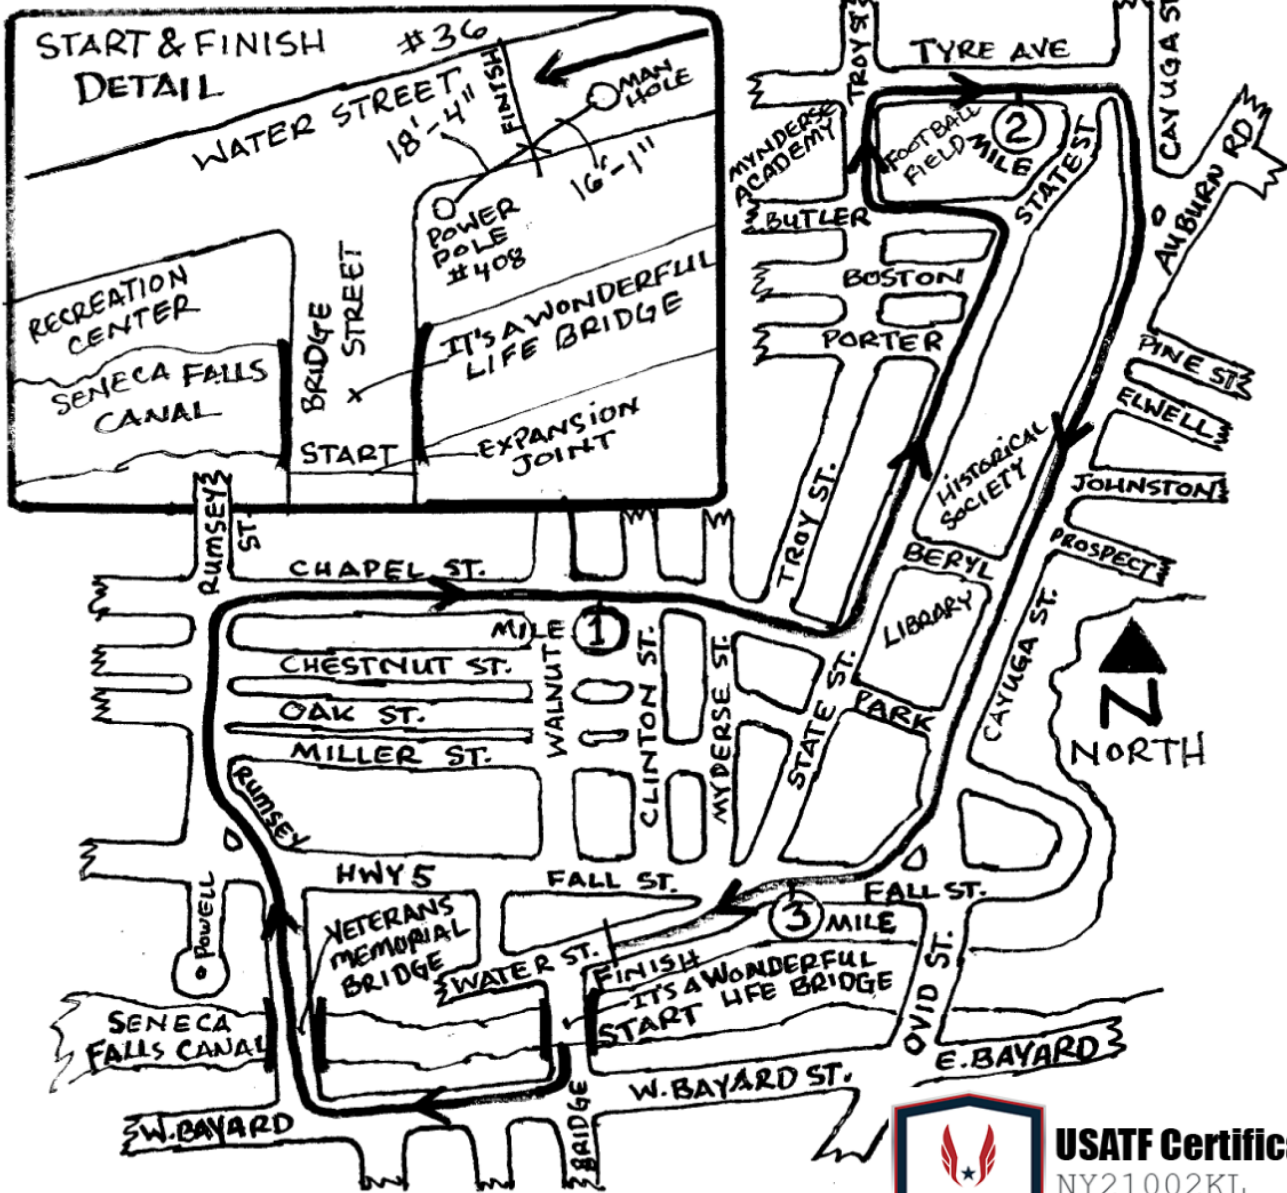

**USATF Certificate**  
NY21002KL  
Effective: 09/23/2021  
Through: 12/31/2031