

# Oak Tree Half Marathon - Geneseo, New York

Measured on: April 20, 2016

By: Kevin P. Lucas - 585-421-9626

## Measured Marks & Elevations:

**Start @ 778 feet elev:** on Avon Road North of Westview Crescent, 36 feet South of crosswalk ahead 30 sign & 82 feet North of speed limit 30 sign, both on West side of road

**1 Mile @ 771 feet elev:** at #15 Main Street, 18 feet North of power pole #RGE 5 on East side of road

**2 Mile @ 793 ft elev:** at #4047 Avon Road, 65 feet 8" North of speed limit 40 sign on West side of road

**3 Mile @ 797 ft elev:** on Avon Road South of Nations Road, 97 feet South of RT39 West sign on West side of road

**5 km @ 805 ft elev:** on Nations Road West of Avon Road, 58 feet East of fence gate on South side of road

**4 Mile @ 599 ft elev:** on Nations Road East of old railroad bridge, 18 feet East of curve sign on North side of road

**5 Mile @ 617 ft elev:** on Roots Tavern Rd East of Nations Rd, 12 feet West of power pole #21 on South side of road

**6 Mile @ 721 ft elev:** at #4159 Roots Tavern Road, 113 feet West of mailbox #4159 on South side of road

**10 km @ 756 ft elev:** at #4220 Roots Tavern Road, 31 feet East of mailbox #4220 on South side of road

**7 Mile @ 783 ft elev:** at #3162 Avon Road, 151 feet South center of driveway on West side of road

**8 Mile @ 691 ft elev:** at #4204 Huston Road, 71 feet West of center of driveway on South side of road

**9 Mile @ 622 ft elev:** #3899 Huston Road, 55 feet East of mailbox #3899 on North side of road

**15 km @ 599 ft elev:** on Huston Road at Nations Road, 41 feet West of stop sign on North side of road

**10 Mile @ 596 ft elev:** on Nations Rd East of Roots Tavern Rd, 198 feet South of street sign on North side of road

**11 Mile @ 642 ft elev:** on Nations Road, 65 feet West of green barn/stable on North side of road

**12 Mile @ 801 ft elev:** on Avon Road, 31 feet South of mile marker 39-4206-1111 on East side of road


**20 km @ 803 ft elev:** at #3986 Avon Road, 64 feet North of power pole #RTC 181 on East side of road

**13 Mile @ 781 elev:** on Geneseo HS track (West side), 9 feet North of storm drain on infield

**Finish @ 785 feet elev:** on Geneseo HS track (East side), at yellow hash marks South end of bleachers, 63 feet North of storm drain on infield & 102 feet 5" South of storm drain on infield



NY16114KL  
Effective  
04/23/2016 to  
12/31/2026

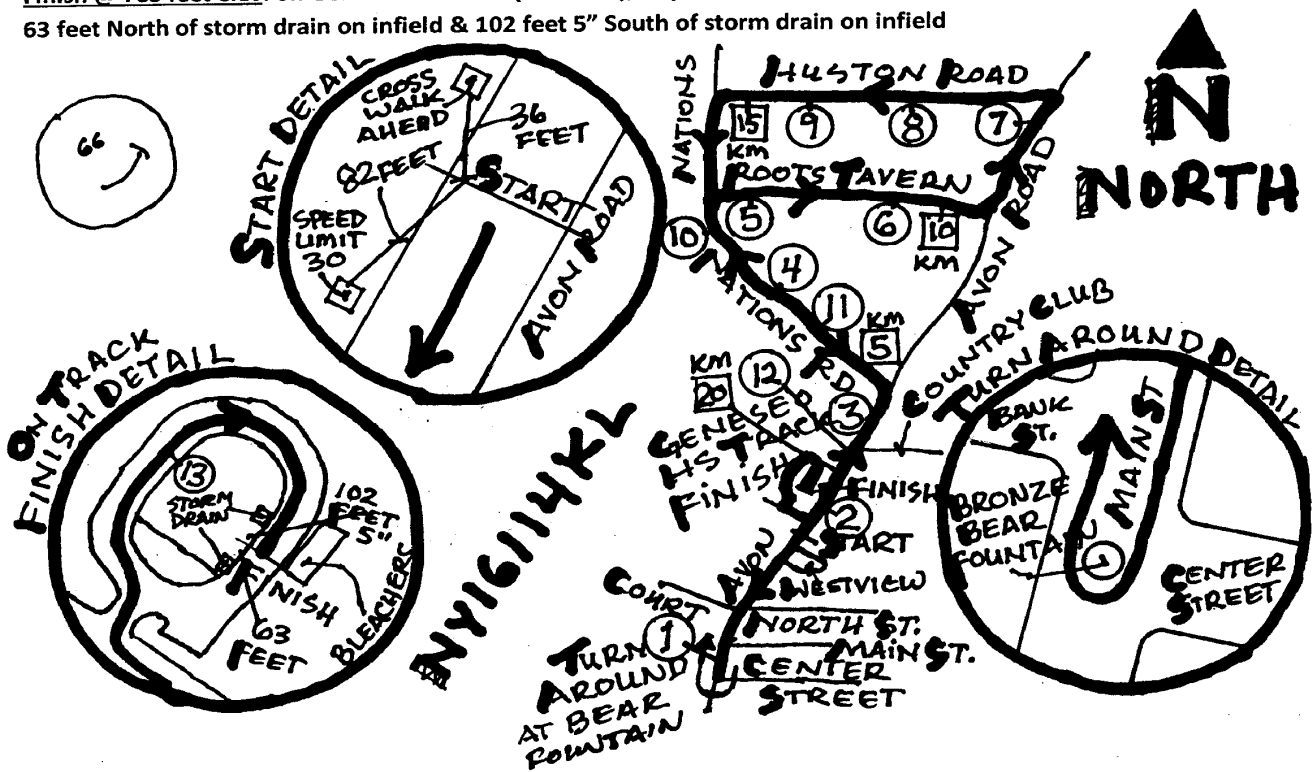



Road Running Technical Council  
USA Track & Field

Measurement Certificate



Name of the course Oak Tree Half Marathon Distance 21.0975 km  
 Location (state) New York (city) Geneseo  
 Type of course: road race  calibration course  track   
 Measuring methods: bicycle  steel tape  electronic distance meter   
 Measured by (name, address, phone & e-mail) Kevin P. Lucas, 94 South Ridge Trail, Fairport, NY  
14450-3843, 585-421-9626 & k p lucas@frontiernet.net  
 Race contact (name, address, phone & e-mail) Benjamin Gajewski, c/o Genesee Valley Conservancy, Inc.,  
PO Box 73 (One Main Street), Geneseo, NY 14454-0073, 585-243-2190  
 Date(s) when course measured: April 20, 2016  
 Number of measurements of entire course: 2 Course Configuration: keyhole  
 Elevation (meters above sea level) Start 237.1 Finish 239.3 Highest 247.2 Lowest 172.8  
 Straight line distance between start & finish 600 meters Drop -0.1 m/km Separation 2.8 %  
 Type of surface: paved <39 % dirt \_\_\_\_\_ % gravel 60> % grass \_\_\_\_\_ % track 1> %  
 Effective date of certification: April 23, 2016 Certification code: NY16114KL

Notice to Race Director: Use this Certification Code in *all* public announcements relating to your race.

Be It Officially Noted That

Based on examination of data provided by the above named measurer, the course described above and in the map attached is hereby certified as reasonably accurate in measurement according to the standards adopted by the Road Running Technical Council. If *any* changes are made to the course, this certification becomes void, and the course must then be recertified.

**Verification of Course** — In the event a National Open Record is set on this course, or at the discretion of USA Track & Field, a verification remeasurement may be required to be performed by a member of the Road Running Technical Council. If such a remeasurement shows the course to be short, then all pending records will be rejected and the course certification will be cancelled.

This certification expires on December 31 in the year 2026

AS NATIONALLY CERTIFIED BY:

Date: April 23, 2016

Kevin P. Lucas – USATF/RRCA Certifier

94 South Ridge Trail, Fairport, NY 14450-3843, 585-421-9626 & k\_p\_lucas@frontiernet.net

Certified Splits:	Start Elevation:	Finish Elevation:	Drop:	Straight Line Distance Start to Finish:	Separation:
5 km	237.1 meters	245.4 meters	-1.66 m/km	2.34 km	46.8%
10 km	237.1 meters	230.4 meters	0.67 m/km	4.47 km	44.7%
15 km	237.1 meters	182.6 meters	3.63 m/km	5.2 km	34.7%
20 km	237.1 meters	244.8 meters	-0.39 m/km	1.18 km	5.1%