

The Fast & The Furriest 5 km

Rochester, New York

Measured on: May 7, 2016

By: Kevin P. Lucas – 585-421-9626



NY16116KL

Effective
05/09/2016 to
12/31/2026


Measured Marks & Elevations:

Start & Finish @ 508 feet elev: at Rochester Animal Services, 184 Verona Street, 28 feet West of power pole #RGE19/RTC103 on East side of road & 11 feet South of storm drain on West side of road

1 Mile @ 514 feet elev: on Ford Street at Atkinson Street intersection, 16 feet South of water valve in road

2 Mile @ 515 feet elev: on Ford Street South of Adams Street, 137 feet South of fire hydrant on East side of road

3 Mile @ 508 feet elev: on Verona Street at brick crosswalk Carestream Health, 170 Verona Street entrance, 9 feet 7" South of storm drain on West side of road

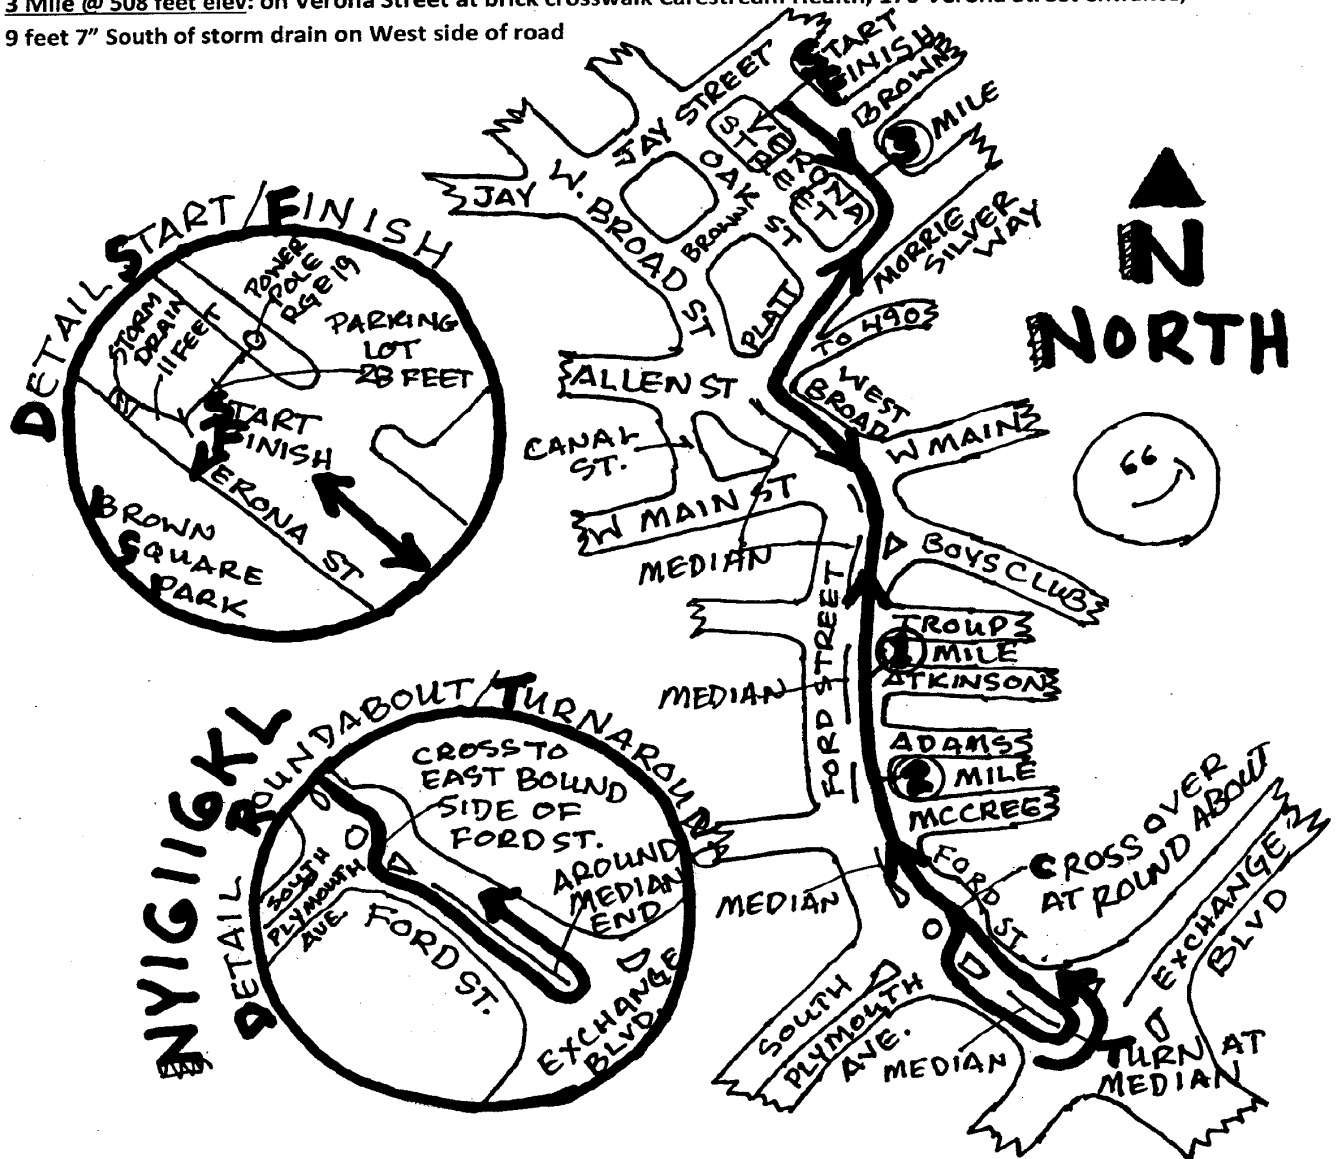



**Road Running Technical Council
USA Track & Field**

Measurement Certificate

recognized by



Name of the course The Fast & The Furriest 5 km Distance 5 km
Location (state) New York (city) Rochester
Type of course: road race ☒ calibration course ☐ track ☐
Measuring methods: bicycle ☒ steel tape ☐ electronic distance meter ☐
Measured by (name, address, phone & e-mail) Kevin P. Lucas, 94 South Ridge Trail, Fairport, NY
14450-3843, 585-421-9626 & k_p_lucas@frontiernet.net
Race contact (name, address, phone & e-mail) Christopher Fitzgerald, c/o Verona Street Animal Society,
184 Verona Street, Rochester, NY 14608-1733, 585-428-7274
Date(s) when course measured: May 7, 2016
Number of measurements of entire course: 2 Course Configuration: out & back
Elevation (meters above sea level) Start 154.8 Finish 154.8 Highest 160.6 Lowest 152.4
Straight line distance between start & finish 0 meters Drop 0.0 m/km Separation 0.0 %
Type of surface: paved 100 % dirt % gravel % grass % track %
Effective date of certification: May 9, 2016 Certification code: NY16116KL

Notice to Race Director: Use this Certification Code
in *all* public announcements relating to your race.

Be It Officially Noted That


Based on examination of data provided by the above named measurer, the course described above and in the map attached is hereby certified as reasonably accurate in measurement according to the standards adopted by the Road Running Technical Council. If *any* changes are made to the course, this certification becomes void, and the course must then be recertified.

Verification of Course — In the event a National Open Record is set on this course, or at the discretion of USA Track & Field, a verification remeasurement may be required to be performed by a member of the Road Running Technical Council. If such a remeasurement shows the course to be short, then all pending records will be rejected and the course certification will be cancelled.

This certification expires on December 31 in the year

2026

AS NATIONALLY CERTIFIED BY:


Kevin P. Lucas – USATF/RRTC Certifier
94 South Ridge Trail, Fairport, NY 14450-3843, 585-421-9626 & k_p_lucas@frontiernet.net

Date: May 9, 2016