

The Fast & The Furriest 10 km

Rochester, New York

Measured on: May 7 & 10, 2016

By: Kevin P. Lucas – 585-421-9626



NY16118KL

Effective

05/12/2016 to

12/31/2026

Measured Marks & Elevations:

Start & Finish @ 508 feet elev: at Rochester Animal Services, 184 Verona St, 28 feet West of power pole #RGE19/RTC103 on East side of road & 11 feet South of storm drain on West side of road

1 Mile @ 514 feet elev: on Ford St at Atkinson St intersection, 16 feet South of water valve in road

2 Mile @ 514 feet elev: on Genesee River Trail at Flint St, 66 feet North of power pole #307 on East side of trail

3 Mile @ 520 feet elev: at grass circle Brooks Landing, 22 feet 5" South of light pole #134 on Plymouth Ave S


Turn Around @ 520 feet elev: at grass circle Brooks Landing, 28 feet 8" South of light pole #134 on Plymouth Ave S & 20 feet 5" West of gas valve near grass circle

5 km @ 535 feet elev: on pedestrian bridge West side, 55 feet 4" East of storm drain at bridge curve

4 Mile @ 515 feet elev: on Genesee River Trail, 74 feet North of light pole #47 on Wilson Blvd. on West side of road

5 Mile @ 515 feet elev: on Ford St at McCree Way, 25 feet 3" North of traffic light pole on East side of road

6 Mile @ 503 feet elev: on Morrie Silver Way at Verona St, 30 feet 2" North of light pole #28R on East side of road

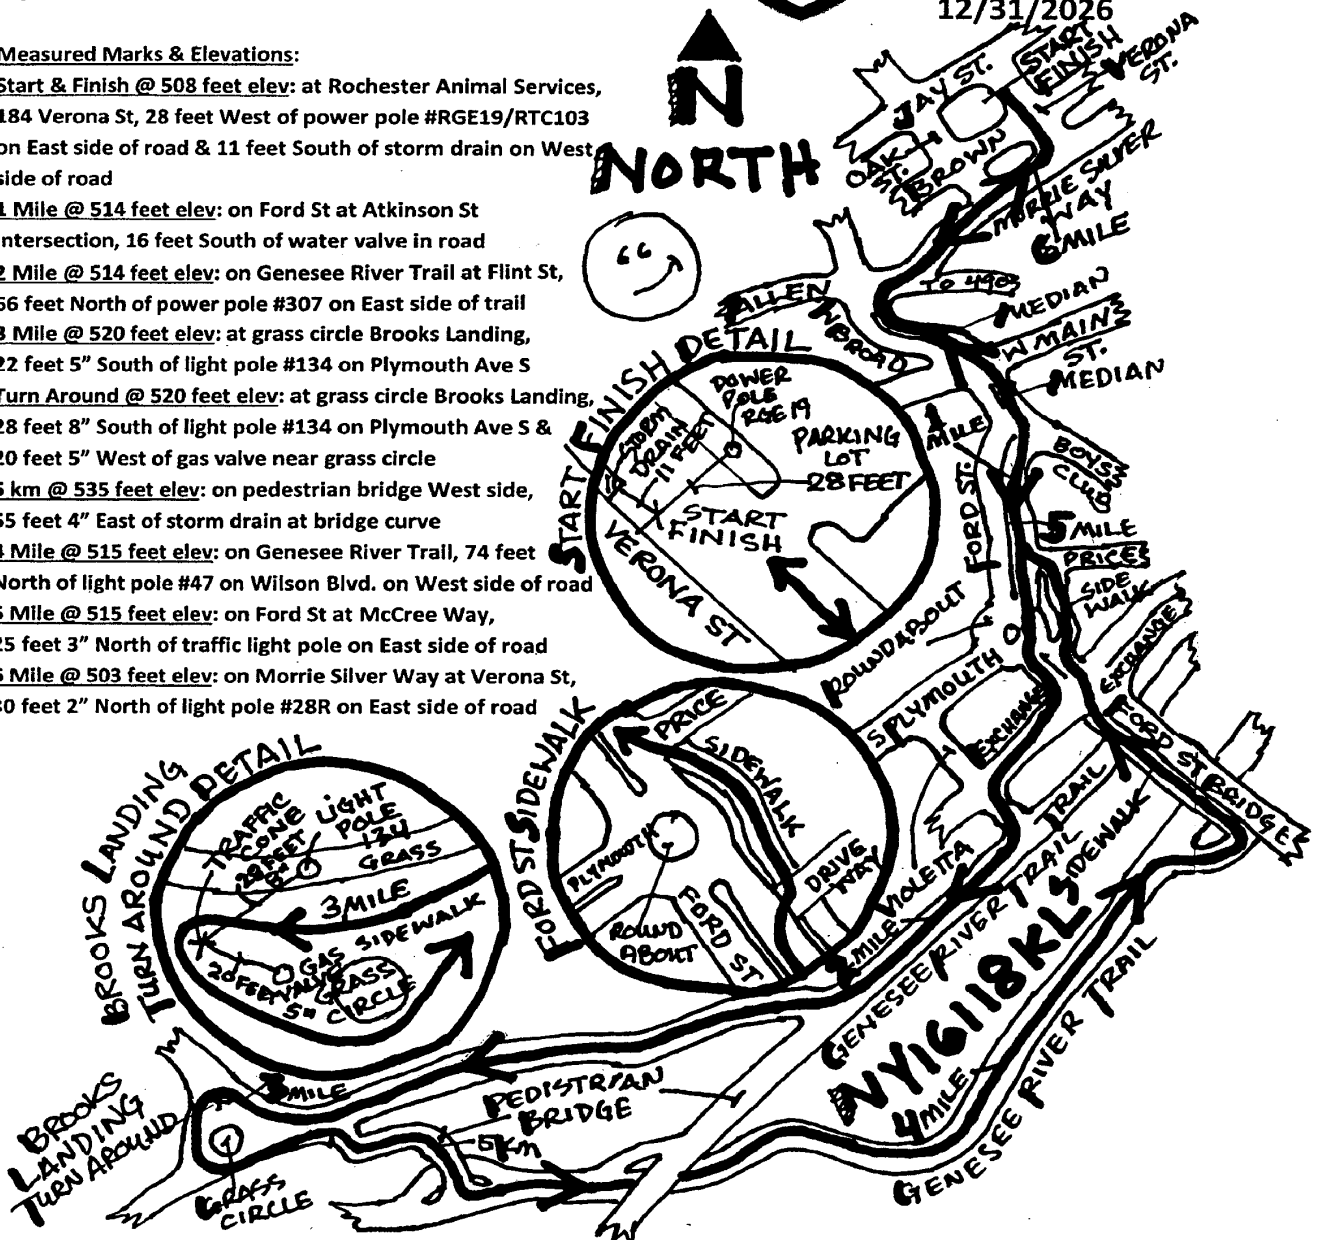



**Road Running Technical Council
USA Track & Field**

Measurement Certificate



Name of the course The Fast & The Furriest 10 km Distance 10 km
Location (state) New York (city) Rochester
Type of course: road race ☒ calibration course ☐ track ☐
Measuring methods: bicycle ☒ steel tape ☐ electronic distance meter ☐
Measured by (name, address, phone & e-mail) Kevin P. Lucas, 94 South Ridge Trail, Fairport, NY
14450-3843, 585-421-9626 & k_p_lucas@frontiernet.net
Race contact (name, address, phone & e-mail) Christopher Fitzgerald, c/o Verona Street Animal Society,
184 Verona Street, Rochester, NY 14608-1733, 585-428-7274
Date(s) when course measured: May 7 & 10, 2016
Number of measurements of entire course: 2 Course Configuration: out & back
Elevation (meters above sea level) Start 154.8 Finish 154.8 Highest 160.6 Lowest 152.4
Straight line distance between start & finish 0 meters Drop 0.0 m/km Separation 0.0 %
Type of surface: paved 100 % dirt % gravel % grass % track %
Effective date of certification: May 12, 2016 Certification code: NY16118KL

Notice to Race Director: Use this Certification Code
in *all* public announcements relating to your race.

Be It Officially Noted That

Based on examination of data provided by the above named measurer, the course described above and in the map attached is hereby certified as reasonably accurate in measurement according to the standards adopted by the Road Running Technical Council. If *any* changes are made to the course, this certification becomes void, and the course must then be recertified.

Verification of Course — In the event a National Open Record is set on this course, or at the discretion of USA Track & Field, a verification remeasurement may be required to be performed by a member of the Road Running Technical Council. If such a remeasurement shows the course to be short, then all pending records will be rejected and the course certification will be cancelled.

This certification expires on December 31 in the year

2026

AS NATIONALLY CERTIFIED BY:



Date: May 12, 2016

Kevin P. Lucas – USATF/RRCA Certifier

94 South Ridge Trail, Fairport, NY 14450-3843, 585-421-9626 & k_p_lucas@frontiernet.net