

Mercy Flight 5 km

Canandaigua, New York

Measured on: November 1, 2016

By: Kevin P. Lucas – 585-421-9626

Measured Marks & Elevations:

Start/Finish @ 798 feet elev: on runway access rd from Mercy Flight, 103 feet West of swale culvert on South side of rd & 581 feet East of 3 Mile mark on North side of rd

1 Mile @ 793 feet elev: on Thomas Rd West of Brickyard Rd, 211 feet West of power pole #RGE 47 at Brickyard Rd on South side of rd

Turn Around @ 786 feet elev: at Thomas Rd dead end, 14 feet South of mailbox #5680 on North side of rd & 15 feet East of No Standing sign on West end of rd (see detail for more)


2 Mile @ 792 feet elev: on Brickyard Rd, 104 feet 6" North of tele. box at airport entrance drive on West side of rd

3 Mile @ 805 feet elev: on runway access rd from Mercy Flight, 108 feet 5" East of maint. rd on North side of rd



NY16128KL

Effective
11/04/2016 to
12/31/2026

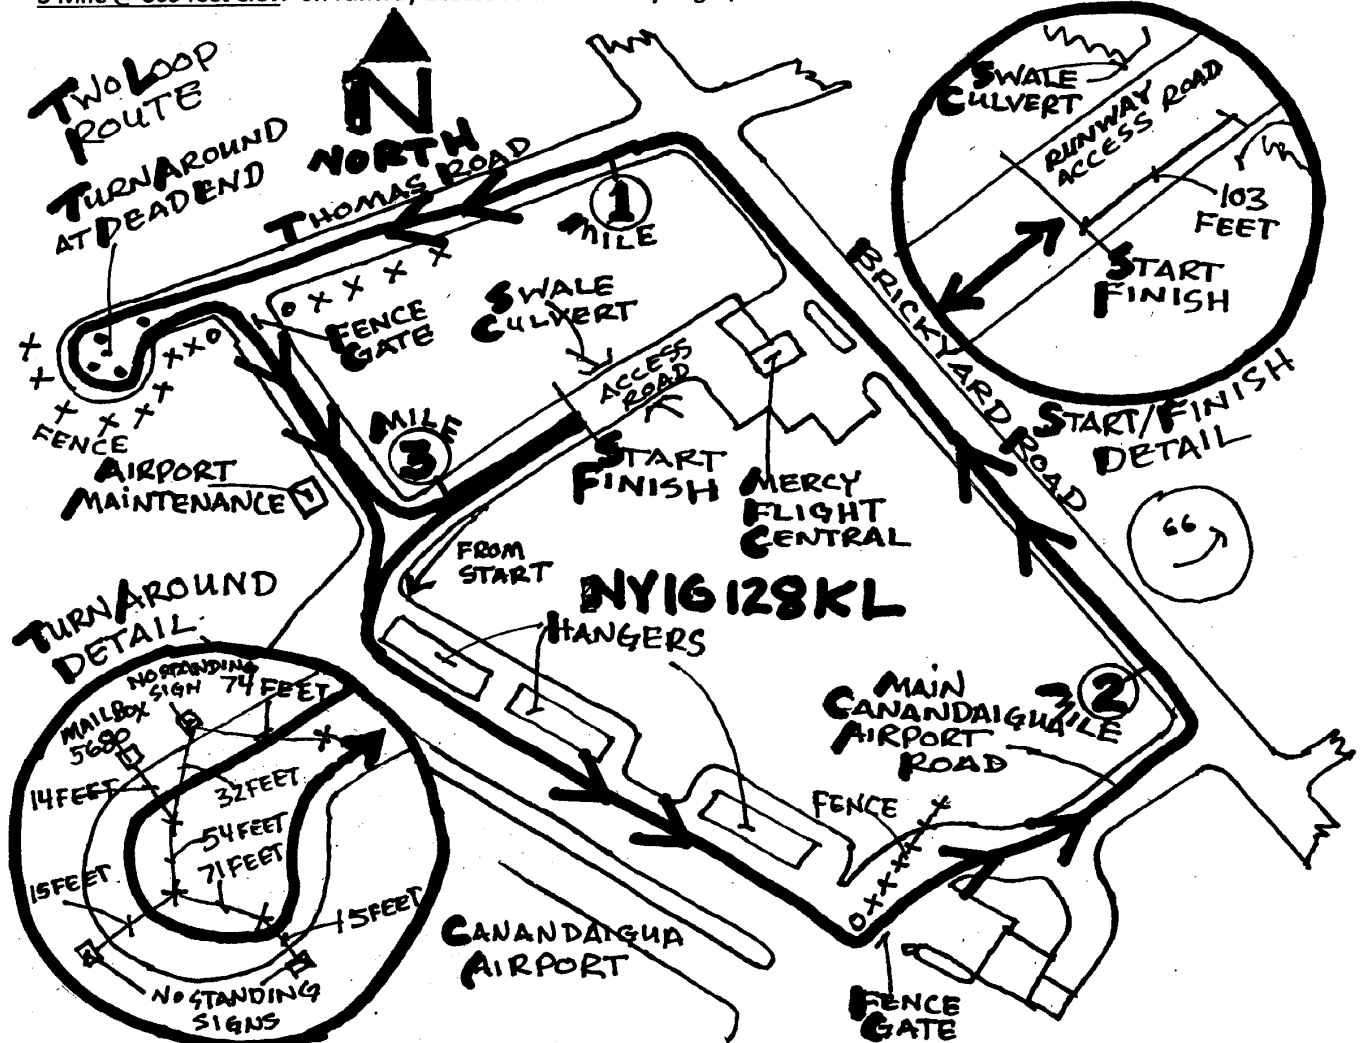



**Road Running Technical Council
USA Track & Field**

Measurement Certificate

recognized by



Name of the course Mercy Flight 5 km Distance 5 km
Location (state) New York (city) Canandaigua
Type of course: road race ☒ calibration course ☐ track ☐
Measuring methods: bicycle ☒ steel tape ☐ electronic distance meter ☐
Measured by (name, address, phone & e-mail) Kevin P. Lucas, 94 South Ridge Trail, Fairport, NY
14450-3843, 585-421-9626 & lucasmeasurement@gmail.com
Race contact (name, address, phone & e-mail) Susan Parrino, c/o Mercy Flight Central Inc.,
2420 Brickyard Road, Canandaigua, NY 14424-7968, 585-396-0584
Date(s) when course measured: November 1, 2016
Number of measurements of entire course: 2 Course Configuration: keyhole
Elevation (meters above sea level) Start 242.6 Finish 242.6 Highest 246.0 Lowest 239.6
Straight line distance between start & finish 0 meters Drop 0 m/km Separation 0 %
Type of surface: paved 95 % dirt % gravel 5 % grass % track %
Effective date of certification: November 4, 2016 Certification code: NY16128KL

Notice to Race Director: Use this Certification Code
in **all** public announcements relating to your race.

Be It Officially Noted That

Based on examination of data provided by the above named measurer, the course described above and in the map attached is hereby certified as reasonably accurate in measurement according to the standards adopted by the Road Running Technical Council. If **any** changes are made to the course, this certification becomes void, and the course must then be recertified.

Verification of Course — In the event a National Open Record is set on this course, or at the discretion of USA Track & Field, a verification remeasurement may be required to be performed by a member of the Road Running Technical Council. If such a remeasurement shows the course to be short, then all pending records will be rejected and the course certification will be cancelled.

This certification expires on December 31 in the year **2026**

AS NATIONALLY CERTIFIED BY:

Date: November 4, 2016

Kevin P. Lucas – USATF/RRTC Certifier

94 South Ridge Trail, Fairport, NY 14450-3843, 585-421-9626 & lucasmeasurement@gmail.com