Heritage Hero 10 km - Seabreeze Amusement Park, Irondequoit, New York

Measured on: May 4, 2019 - By: Kevin P. Lucas - lucasmeasurement@gmail.com

USAT!

05/09/2019 to

Effective

12/31/2029

NY19103KL

Measured Marks & Elevations

Start @ 327 feet elevation: in Seabreeze Amusement Park at Bumper Cars entrance gate post


Mile @ 346 feet elevation: at #24 Keating Dr., 28 feet 7" East of center of driveway on North side of road

2 Mile @ 285 feet elevation: on Lakeside Trail East of Zoo Road, 18 feet East of fire hydrant on West side of trail

5 km @ 264 feet elevation: on Lakeside Trail North of Treatment Plant, 160 feet 6" West of gym equipment on North side of trail 3 Mile @ 257 feet elevation: on Lakeside Trail North of Sherry Pond, 71 feet 8" West of storm manhole at white pump box on North side of trail

Turn-Around @ 267 feet elevation: on Lakeside Trail North of Camp Eastman, 55 feet North of trail bollards & 8 feet 4" East of Lakeside Trail sign

6 Mile @ 324 feet elevation: in Seabreeze Amusement Park at Seabreeze Grill, 14 feet 3" North of Midway roof post 5 Mile @ 298 feet elevation: on Lakeside Trail East of Pine Valley Road, 90 meters East trail bench on West side of trail 4 Mile @ 253 feet elevation: on Lakeside Trail West of Horseshoe Road, 200 meters West of Lakeside Trail sign on North side of trail at Parking Lot C

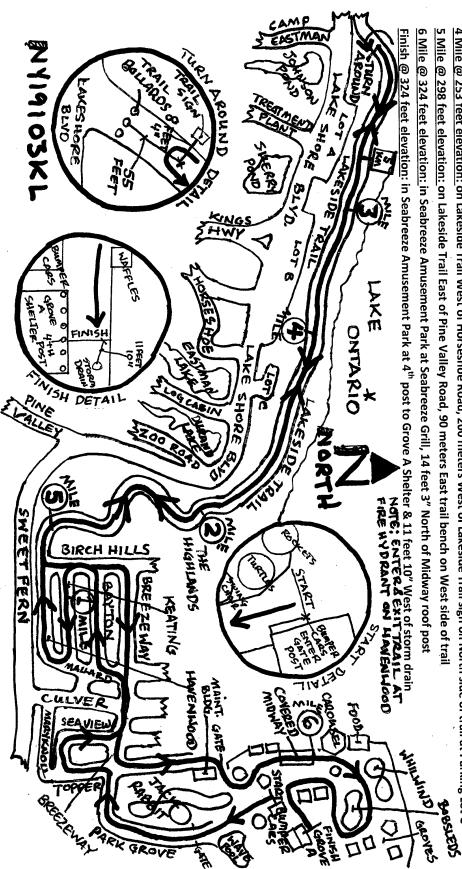



Road Running Technical Council USA Track & Field



Measurement	Certificate
Mension Chilert	certificate

Name of the course	Heritage Hero 10 km				Distance 10 km		0 km
Location (state)	New York	(city)			Irondequ	oit	
	e calibration cou cle steel tape s, phone & e-mail) <u>Kev</u>	rse	istance met 4 South F	er 🗌	il, Fairpo	ort, NY	
Race contact (name, address 275 Kenneth Drive, Suite Date(s) when course measure	s, phone & e-mail) Kelly 100, Rochester, NY 14	Nash, c/o Herita	age Christia 340-5780	in Services			
Number of measurements of		Course Config				hole	
Elevation (meters above sea	level) Start 99.7	Finish	98.7	Highest	108.2	Lowest	77.1
Straight line distance between	en start & finish 4	1 meters	Drop	0.10 m	ı/km S	— — eparation _	0.41 %
Type of surface: paved	100 % dirt	% gravel	%	grass	%	track	%
Effective date of certification							
	Be It Of	ficially I	in <i>all</i> p	ublic annou		this Certific s relating to	cation Code your race.
in the map attac dards adopted by	nation of data provided be hed is hereby certified a the Road Running Tech es void, and the course m	s reasonably accinical Council. If	curate in mo any change	easurement	t accordin	g to the sta	ın-
of USA Track & the Road Runnir	Course — In the event a large Field, a verification renger Technical Council. If will be rejected and the council and the council the council and the council	neasurement may such a remeasur	be required rement show	d to be peri	formed by	a member	of
This co	ertification expires	on Decembe	r 31 in th	e year [2029		
S. marting	AS NATIO	ONALLY CEA	RTIFIEL	BY:			

Kevin P. Lucas - USATF/RRTC Certifier

94 South Ridge Trail, Fairport, NY 14450-3843, 585-421-9626 & lucasmeasurement@gmail.com