



*Road Running Technical Council
USA Track & Field
Measurement Certificate*



Name of the course Runnin' of the Green 5 Mile 2020 Distance 5 mi

Location (state) NY (city) Rochester

Type of course: Road Race

Measuring Methods: Bicycle

Measured By Kevin Lucas - 94 South Ridge Trail - Fairport, NY 14450 - (585) 421-9626 - lucasmeasurement@gmail.com

Race Contact Jonathan Griffiths - Rochester Running Co., 1387 Mt. Hope Ave., Rochester, NY 14620 - 585-417-5575

Date(s) when course measured: 02/22/2020

Number of measurements of entire course: 2 Course Configuration: same out/back

Elevation (meters above sea level) Start 155.45 Finish 155.45 Lowest 155.45 Highest 168.55

Straight line distance between start and finish 0 m Drop 0.00 m/km Separation 0.00 %

Type of surface: Paved 100 % Dirt 0 % Gravel 0 % Grass 0 % Track 0 %

Effective date of certification: February 27, 2020 Certification code: NY20001KL

Note to Race Director: Use this Certification Code
in all public announcements relating to your race.

Be It Officially Noted That

Based on examination of data provided by the above named measurer, the course described above and in the map attached is hereby certified as reasonably accurate in measurement according to the standards adopted by the Road Running Technical Council. If any changes are made to the course, this certification becomes void, and the course must then be recertified.

Verification of Course --- In the event a National Open Record is set on the course, or at the discretion of USA Track & Field, a verification measurement may be required to be performed by a member of the Road Running Technical Council. If such a remeasurement shows the course to be short, then all pending records will be rejected and the course certification will be cancelled.

This certification expires on December 31 of the year: **2030**

AS NATIONALLY CERTIFIED BY:

Date: December 30, 2021

Kevin Lucas - USATF/RRTC Certifier - 94 South Ridge Trail, Fairport NY 14450
(585) 421-9626 - lucasmeasurement@gmail.com

Runnin' of the Green 5 Mile

Rochester, New York

Measured on: February 22, 2020

By: Kevin P. Lucas – lucasmmeasurement@gmail.com



USATF Certificate
NY20001KL
Effective: 02/27/2020
Through: 12/31/2030

Measured Marks & Elevations:

Start/Finish @ 510 feet elevation: on Exchange Blvd, North of Court St.,

at storm drain & 10 feet North of man hole cover on East side of road

1 Mile/4 Mile @ 526 feet elevation: on Wilson Blvd. South of Ford St.

at The Episcopal Senior Life Community maintenance lot,

66 feet South of storm drain on East side of road

2 Mile @ 522 elevation: on Wilson Blvd. East of Library,

62 feet East of light pole #41 on North side of road

Turn Around @ 553 feet elevation: on Wilson Blvd.

South of traffic circle at Fraternity, at light pole


on East side of road & between handicapped

parking spaces on both sides of road

3 Mile @ 522 feet elevation: on Wilson Blvd. East of Library,

41 feet West of light pole #4 on South side of road

West of Anderson Tower

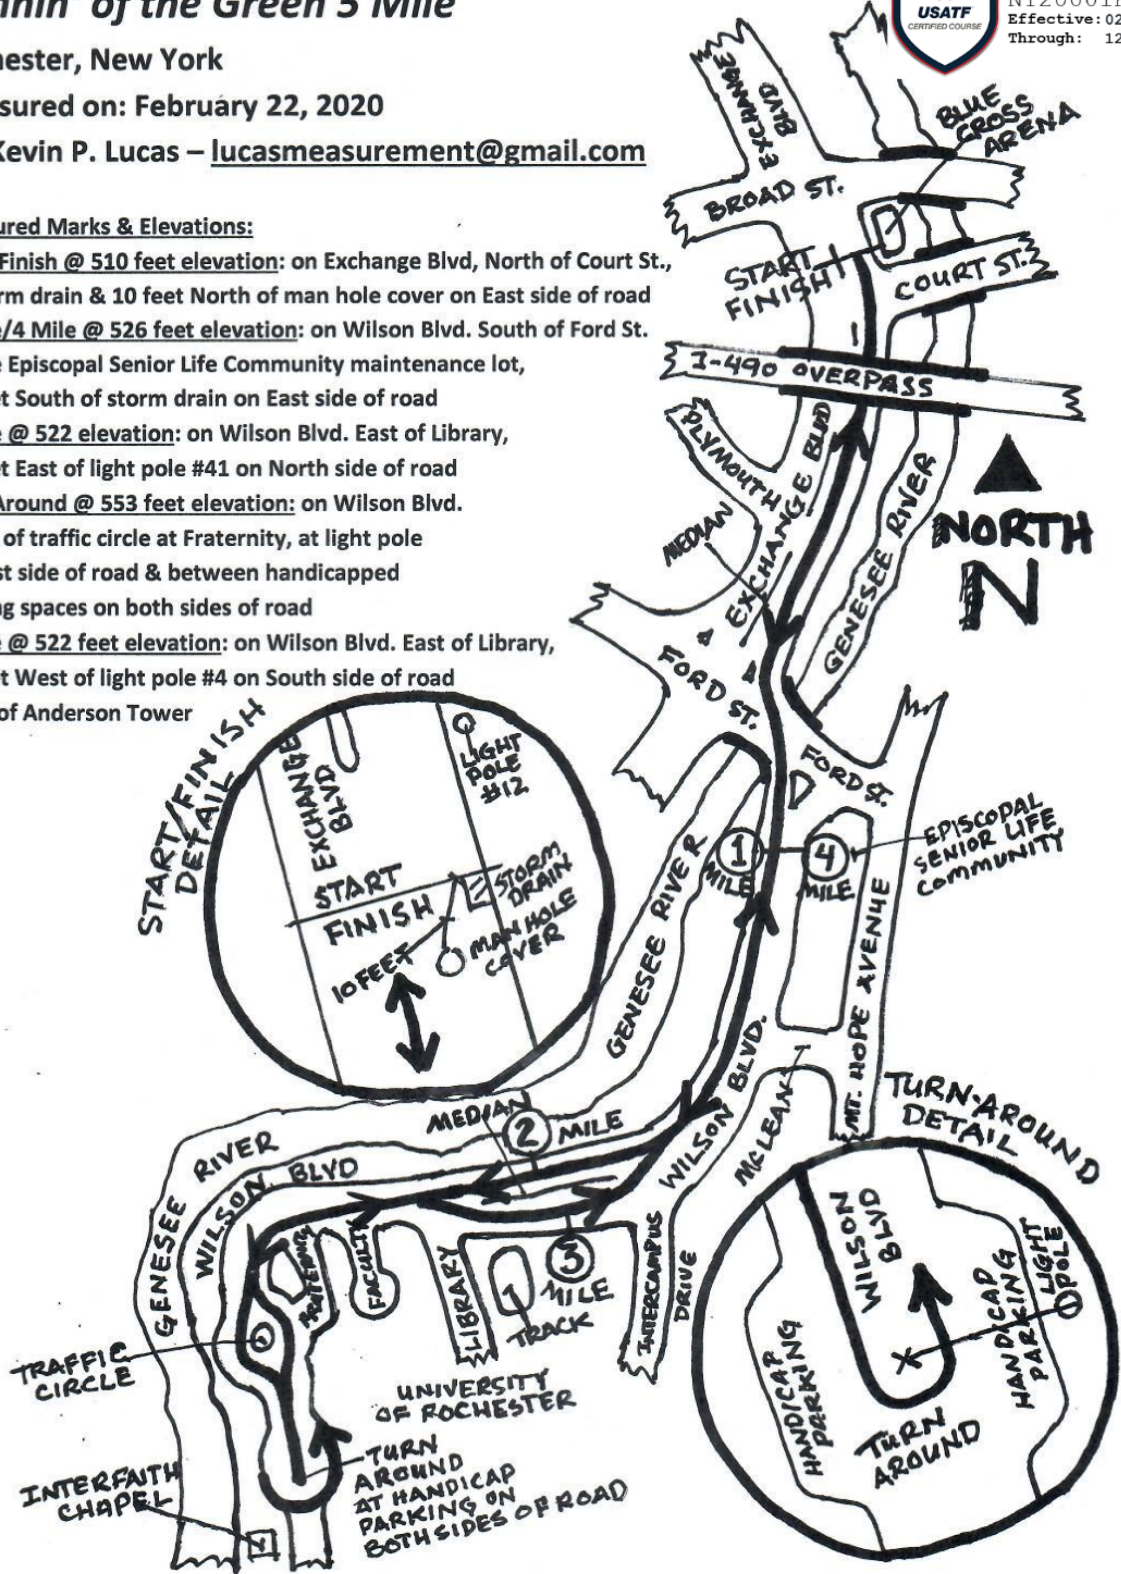

"THIS COURSE WAS MEASURED USING THE FULL WIDTH OF THE ROAD AND THE SHORTEST POSSIBLE ROUTE (SPR)."